IREDELL COUNTY HEALTH DEPARTMENT

STATESVILLE 704-878-5305 MOORESVILLE 704-664-5281

IMPROVEMENT PERMIT / AUTHORIZATION TO CONSTRUCT / OPERATION PERMIT / EXISTING SYSTEM INSPECTION

PERMIT# 91949 PIN# 4771 35 15 43 DATE 10/4/00

OWNER OR CONTRACTOR Fleetwood Homes PHONE: Business 525-7120 Home

ADDRESS 1040 Charlotte Hwy Troutman NC 28166

LOCATION 77E R Tripplet, R Water mess, R Wingate Arbor on Rt

SUBDIVISION Willow Ridge BLOCK / SECTION LOT 14 LOT AREA 1.77 AC SITE CLASS PS DESIGN FLOW 360 L.T.A.R. 0.25

Septic Tank: 1000 Gallons: STB 1012 Date 7/2/2000
Pump Tank: Gallons: PT Date
Pump Make: Model Serial No.
Nitrification Field: No Fields 1 Square Feet 1440 Linear Feet 480
No Lines 6@80' Trench Width 36" Max Trench Bottom Depth 36" Gravel Depth 12"

☒ New System ☐ Repair System Type: I (II) III IV V VI
System Description: Grav. conv.
Repair System Description: Same
Maintenance Agreement Required: ☐ Yes ☒ No

☐ House/Mod. Home ☒ Mobile Home ☐ Business ☐ Other
No. Bedrooms 3 No. Bathrooms 2 No. Employees


☐ Slab ☒ Crawl Space ☐ Basement w/plumbing ☐ Basement wo/plumbing

Water Supply: ☒ Individual ☐ Public ☐ Community


Comments/Conditions: Trenches must be 36" deep
Keep well a minimum of 50' from
Septic System

Comments/Conditions:

INITIAL SITE SKETCH

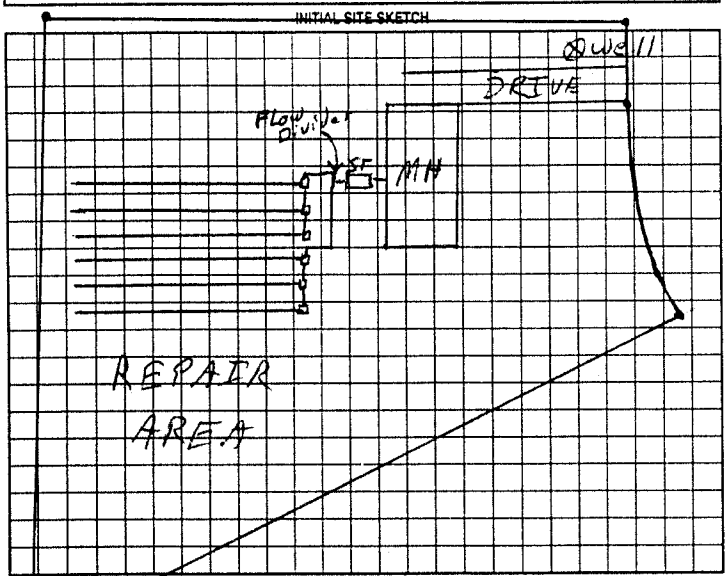

AS BUILT SKETCH

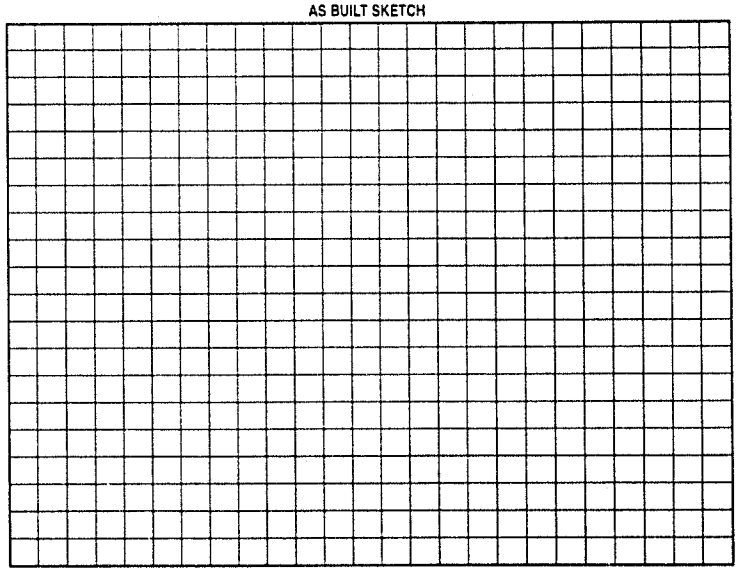

Permit can be suspended or revoked if any false information is supplied toward securing the permit/any unauthorized changes are made to the site/any unauthorized changes are made in the installation of the system. Improvement Permit with plat valid without expiration. Improvement Permit with site plan valid for sixty months. Authorization to Construct is valid for a period equal to that of Improvement Permit – not to exceed sixty months.

Signed: CR RS date 10-4-00 Installed by: Craig Thompson

Improvement Permit by: RSI date 10/4/00 Operation Permit by: RSI date 10/6/00

Authorization to Construct by: RSI date 10/4/00 Existing System Inspection by: date

HEALTH DEPT. COPY: WHITE OWNER COPY (FINAL): YELLOW OWNER COPY (INITIAL): PINK