(E1)

IREDELL COUNTY HEALTH DEPARTMENT

STATESVILLE 704-878-5305 MOORESVILLE 704-664-5281

IMPROVEMENT PERMIT / AUTHORIZATION TO CONSTRUCT / OPERATION PERMIT / EXISTING SYSTEM INSPECTION

PERMIT# 14826320 PIN# 4771356730 DATE 2/8/08

OWNER OR APPLICANT Freedom Homes PHONE: Business 704.528.7960 Home

ADDRESS 1042 Charlotte Hwy Troutman, NC 28166

LOCATION 70 E, TR Triplett, TL Watermess, TR Winding Arbor Cir (2nd) on Rt just before Curve

SUBDIVISION Willow Ridge BLOCK / SECTION NA LOT 35 LOT AREA 0.76 acre SITE CLASS P.S. DESIGN FLOW 360 L.T.A.R. 0.3

Septic Tank: ~~1000~~ Existing Gallons: STB Existing Date Existing

Pump Tank: Gallons: PT Date

Pump Make: Model Serial No.

Nitrification Field. No Fields 1 Square Feet 400 Linear Feet 100

No Lines 2 Trench Width 36" Max Trench Bottom Depth 36" Gravel Depth NA

☐ New System ☐ Repair ☒ Expansion System Type: I II III IV V VI

System Description: 25% Reduction

Repair System Description: pump to 25% Reduction

Maintenance Agreement Required: ☐ Yes ☐ No

☒ House/Mod. Home ☐ Mobile Home ☐ Business ☐ Other

No. Bedrooms 3 No. Persons No. Employees

Water Supply: ☒ Individual ☐ Public ☐ Community


☐ Gravity ☐ Pressure ☐ Slab ☒ Crawl Space ☐ Basement w/plumbing ☐ Basement wo/plumbing

Comments:/Conditions:


- Install on Contour, as flagged on site
- Install Distribution Box at existing third line
- ~~Use End Cap if~~
- Mountain Set backs.

Comments:/Conditions:

1921 INITIAL SITE SKETCH

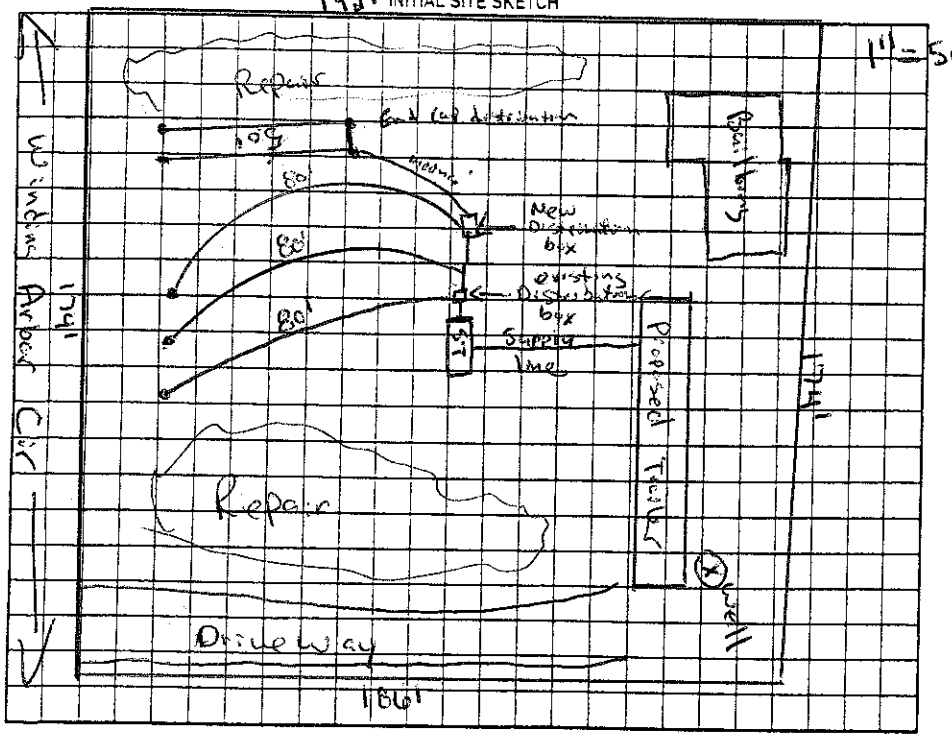

AS BUILT SKETCH

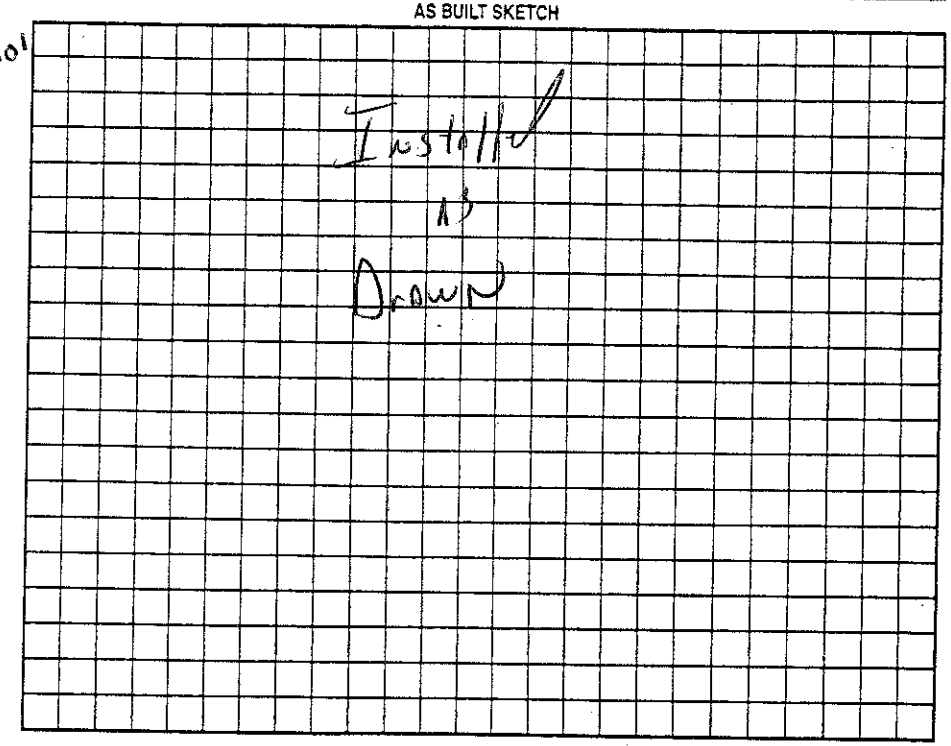

Permit can be suspended or revoked if any false information is supplied toward securing the permit/any unauthorized changes are made to the site/any unauthorized changes are made in the installation of the system. Improvement Permit with plat valid without expiration ☐ Improvement Permit with site plan valid for sixty months ☒ Authorization to Construct is valid for a period equal to that of Improvement Permit – not to exceed sixty months.

Signed: date 2-15-08 Installed by: Tim Rhee

Improvement Permit by: date 2/8/08 Operation Permit by: R.S. date 6 March 08

Authorization to Construct by: date 2/8/08 Existing System Inspection by: date

HEALTH DEPT. COPY: WHITE OWNER COPY (FINAL): YELLOW OWNER COPY (INITIAL): PINK