IREDELL COUNTY HEALTH DEPARTMENT

STATESVILLE 704-878-5305 MOORESVILLE 704-664-5281

56154

IMPROVEMENT PERMIT / CERTIFICATE OF COMPLETION / OPERATION PERMIT / EXISTING SYSTEM INSPECTION

PROPERTY DESCRIPTION NO. 21209 DATE 5-26-95 TAX MAP NO. 5F-2-A-19 Watershed: ☐ Yes ☑ No

OWNER OR CONTRACTOR Lonnie Holmes PHONE: Business _____ Home 528 4938

ADDRESS 184 Winding Arbor Circle

LOCATION Hwy 70 E TR Triplett Rd Th Watermoss TR Winding Arbor 1/4 mi on Rt

SUBDIVISION Willow Ridge BLOCK / SECTION _____ LOT 19 LOT AREA 1.85 acres SITE CLASS. F5 DESIGN FLOW 240 L.T.A.R. .3

Septic Tank: 1000 Gallons; STB 854 Date 4-10-95

Pump Tank: _____ Gallons; PT _____ Date _____

Pump Make: _____ Model _____ Serial No. _____

Nitrification Field. No Fields 1 Square Feet 810 Linear Feet 270

No Lines 3 Trench Width 36" Max Trench Bottom Depth 24" Gravel Depth 12"

☑ New System ☐ Repair System Type: I, II, III, IV, V, VI

System Description: Conv. Gravity

Repair System Description: Pump To Conv. lines

Maintenance Agreement Required: ☐ Yes ☑ No

☐ Slab ☑ Crawl Space ☐ Basement w/plumbing ☐ Basement wo/plumbing

☐ House/Mod. Home No. Bedrooms 2

☑ Mobile Home No. Bathrooms 2

☐ Business No. Employees _____


☐ Other _____

Water Supply: ☑ Individual ☐ Community ☐ Public

Comments:

Comments: well & MH not located at time of this inspection keep proper distances from S.T.

INITIAL SITE SKETCH

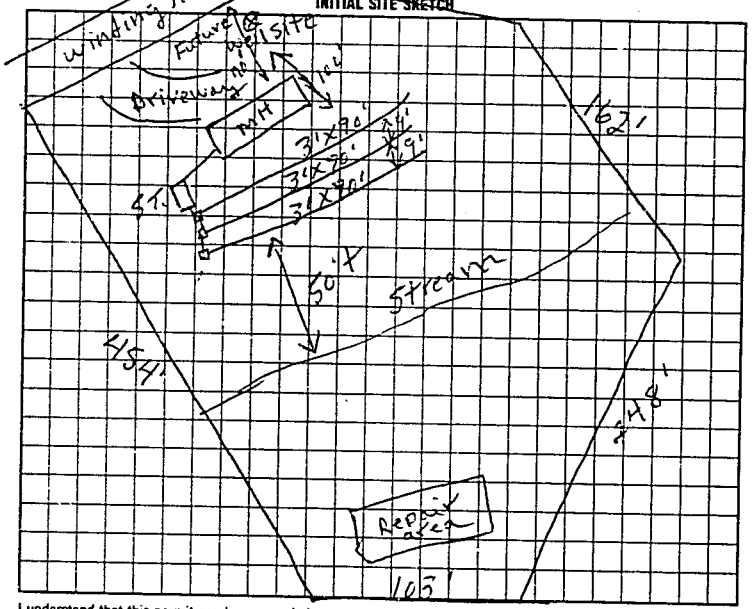

AS BUILT SKETCH

Same as initial sketch

I understand that this permit can be suspended or revoked if any false information is supplied toward securing the permit/any unauthorized changes are made to the site/any unauthorized changes are made in the installation of the system. Improvement Permit is valid for 60 months from date of issuance.

Signed: x Lonnie Holmes

Improvement Permit by: L. C. Moore date 5-26-95

Existing System Inspection by: _____ date _____

Installed by: Union Grove S.T. Co.

Certificate of Completion by: L. C. Moore date 6-1-95

Operation Permit by: _____ date _____

HEALTH DEPT. COPY: WHITE INSPECTION COPY (FINAL): GREEN OWNER COPY (FINAL): YELLOW INSPECTION COPY (INITIAL): PINK OWNER COPY (INITIAL): GOLD