IREDELL COUNTY HEALTH DEPARTMENT

STATESVILLE 704-878-5305 MOORESVILLE 704-664-5281

IMPROVEMENT PERMIT / CERTIFICATE OF COMPLETION / OPERATION PERMIT / EXISTING SYSTEM INSPECTION

PROPERTY DESCRIPTION NO 164317 DATE 6-2-93 TAX MAP NO 5F-2-A-20

OWNER OR CONTRACTOR Michael Gregory PHONE Business Home 663-4184

ADDRESS 620 Ashe St Mooresville N.C.

LOCATION 70E TR Triplett approx 4mi TL Water Moss TR Winding Arbor 1/4 mi on the Rt

SUBDIVISION Willow Ridge BLOCK / SECTION LOT 20 LOT AREA .98 acres SITE CLASS P.S. L.T.A.R. .3

Water Supply: [ ] Individual [ ] Community [ ] Public

Septic Tank: 1000 Gallons; STB 794 Date 11-23-93

Pump Tank: Gallons; PT Date

Nitrification Field: No Fields 1 Square Feet 1200 Linear Feet 400

No Lines 4 Trench Width 36 Trench Depth 24 Gravel Depth 12"

[ ] New System [ ] Repair System Type: [ ] I [ ] II [ ] III [ ] IV [ ] V [ ] VI

System Description: conv. Gravity

Repair System Description:

Maintenance Agreement Required: [ ] Yes [ ] No

[ ] House/Mod. Home [ ] Mobile Home [ ] Business [ ] Other

No. Bedrooms 3 No. Bathrooms 2 No. Employees

[ ] Slab [ ] Crawl Space [ ] Basement w/plumbing [ ] Basement wo/plumbing

Garbage Disposal: [ ] Yes [ ] No


Auto. Dishwasher: [ ] Yes [ ] No

Auto. Washing Machine: [ ] Yes [ ] No


Other

Comments: Right Part of lot Below Drive will need Tofe Plantscape Smooth So. Drainlines Can Run Into this area

INITIAL SITE SKETCH

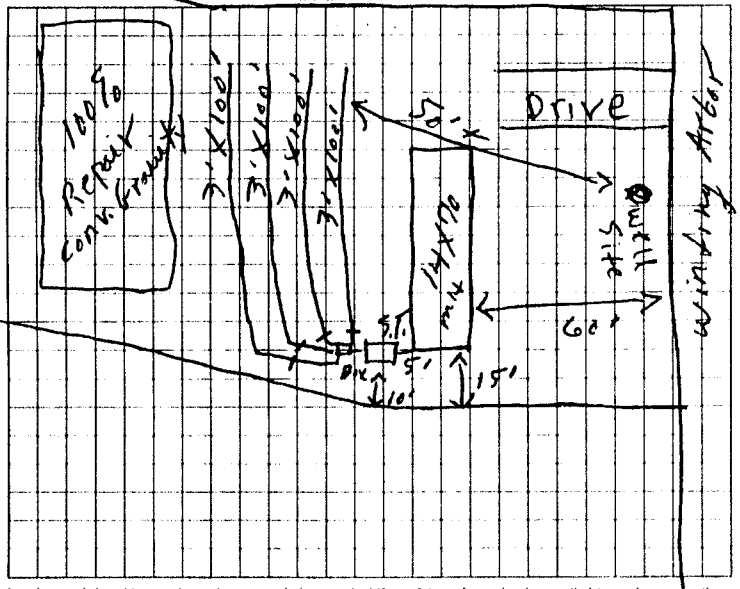

AS BUILT SKETCH

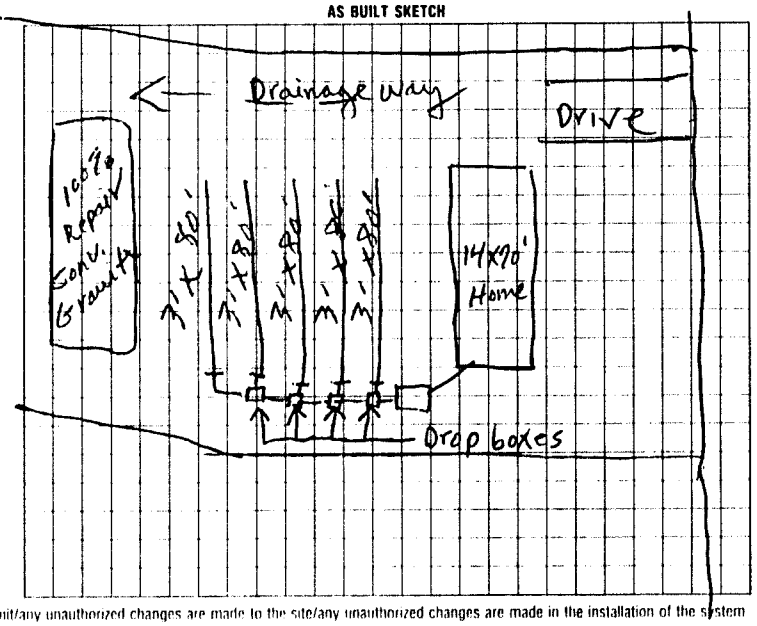

I understand that this permit can be suspended or revoked if any false information is supplied toward securing the permit/any unauthorized changes are made to the site/any unauthorized changes are made in the installation of the system Improvement Permit is valid for 60 months from date of issuance

Signed: xMike Sykes Gregory

Improvement Permit by P. C. Moore date 6-2-93

Existing System Inspection by date

Installed by Dellinger S.T. Co.

Certificate of Completion by P. C. Moore date 3-8-94

Operation Permit by date

HEALTH DEPT COPY WHITE INSPECTION COPY (FINAL) GREEN OWNER COPY (FINAL) YELLOW INSPECTION COPY (INITIAL) PINK OWNER COPY (INITIAL) GOLD