IREDELL COUNTY HEALTH DEPARTMENT

STATESVILLE 704-878-5305 MOORESVILLE 704-664-5281

IMPROVEMENT PERMIT / AUTHORIZATION TO CONSTRUCT / OPERATION PERMIT / EXISTING SYSTEM INSPECTION

PERMIT# 79295 PIN# 4771358473 DATE 2-4-99

OWNER OR CONTRACTOR Carlos Camacho PHONE: Business Home 528 9449

ADDRESS 1018 Charlotte Hwy Troutman (198 Winding Arbor Lane)

LOCATION 70S TR Triplett TL water Moss TR Winding Arbor Lane

SUBDIVISION Willow Ridge BLOCK / SECTION LOT 20 LOT AREA .98 acres SITE CLASS PS DESIGN FLOW 360 L.T.A.R. .3

Septic Tank: 1000 Gallons; STB 794 Date 11-23-93

Pump Tank: Gallons; PT Date

Pump Make: Model Serial No.

Nitrification Field: No Fields 1 Square Feet 1200 Linear Feet 400

No Lines 5 Trench Width 36" Max Trench Bottom Depth 24" Gravel Depth 12"

✓ New System Repair System Type: I II III IV V VI

System Description: conv Gravity

Repair System Description: " "

Maintenance Agreement Required: Yes ✓ No

Slab ✓ Crawl Space Basement w/plumbing Basement wo/plumbing

✓ House/Mod. Home No. Bedrooms 3

✓ Mobile Home No. Bathrooms 2

Business No. Employees


Other

Water Supply: ✓ Individual ☐ Public ☐ Community


Comments/Conditions:

Comments/Conditions

INITIAL SITE SKETCH

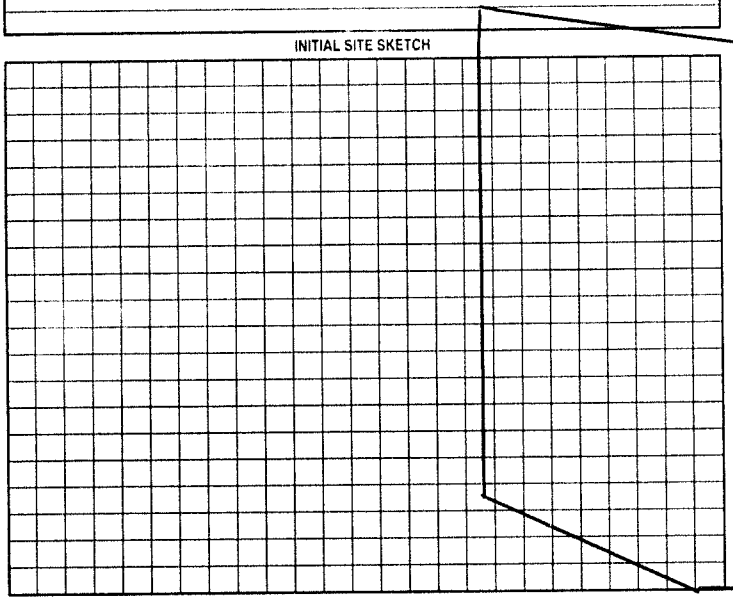

AS BUILT SKETCH

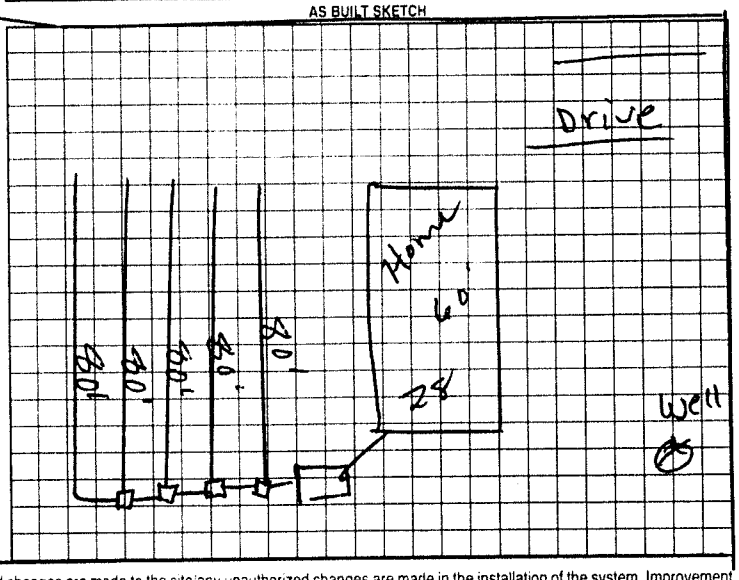

Permit can be suspended or revoked if any false information is supplied toward securing the permit/any unauthorized changes are made to the site/any unauthorized changes are made in the installation of the system. Improvement Permit with plat valid without expiration. Improvement Permit with site plan valid for sixty months. Authorization to Construct is valid for a period equal to that of Improvement Permit not to exceed sixty months.

Signed: date Installed by: Pellinger S.T. Co.

Improvement Permit by: date Operation Permit by: ✓ P. C. Moore date 3-8-94

Authorization to Construct by: date Existing System Inspection by: ✓ P. C. Moore date 2-4-99

HEALTH DEPT COPY WHITE OWNER COPY (FINAL) YELLOW OWNER COPY (INITIAL) PINK