IREDELL COUNTY HEALTH DEPARTMENT

STATESVILLE 704-878-5305 (CA) MOORESVILLE 704-664-5281

IMPROVEMENT PERMIT / AUTHORIZATION TO CONSTRUCT / OPERATION PERMIT / EXISTING SYSTEM INSPECTION

PERMIT# 14745 PIN# 4771360754 DATE 2-20-08

OWNER OR APPLICANT Vicki Ruff PHONE: Business 704-528-4350 Home

ADDRESS 441 Quail Run Dr Mooresville 28115

LOCATION 70E to Turnette Rd Watermass

SUBDIVISION Willow Ridge BLOCK / SECTION 1 LOT 5 LOT AREA 0.205 SITE CLASS. PS DESIGN FLOW 360 L.T.A.R.

Septic Tank: 1000 Gallons; STB EXIST Date EXIST

Pump Tank: 1000 Gallons; PT EXIST Date EXIST

Pump Make: Model Serial No.

Nitrification Field: No Fields Square Feet 1440 Linear Feet 360

No Lines 5 Trench Width 36" Max Trench Bottom Depth 31" Gravel Depth 12" ☐ Gravity ☐ Pressure

☐ New System ☐ Repair ☐ Expansion System Type: I II III IV V VI

System Description: Conven. pump

Repair System Description: 25% pump

Maintenance Agreement Required: ☐ Yes ☐ No

☑ House/Mod. Home No. Bedrooms 3

☐ Mobile Home No. Persons 2

☐ Business No. Employees

☐ Other

Water Supply: ☑ Individual ☐ Public ☐ Community


☐ Slab ☑ Crawl Space ☐ Basement w/plumbing ☐ Basement wo/plumbing

Comments:/Conditions:


Comments:/Conditions:

Pump tank has risen

INITIAL SITE SKETCH

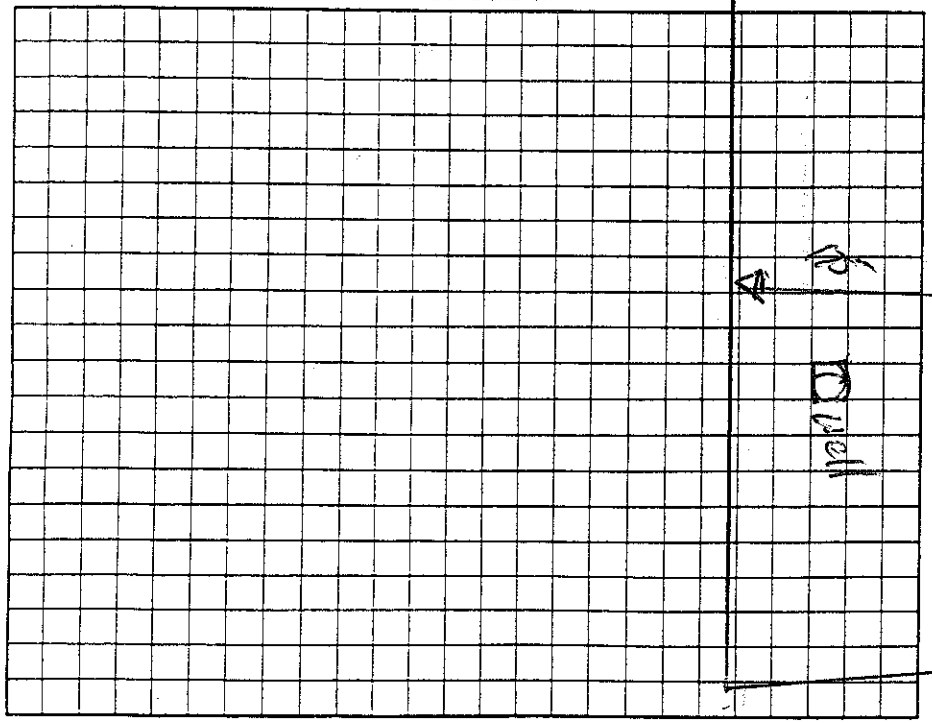

AS BUILT SKETCH

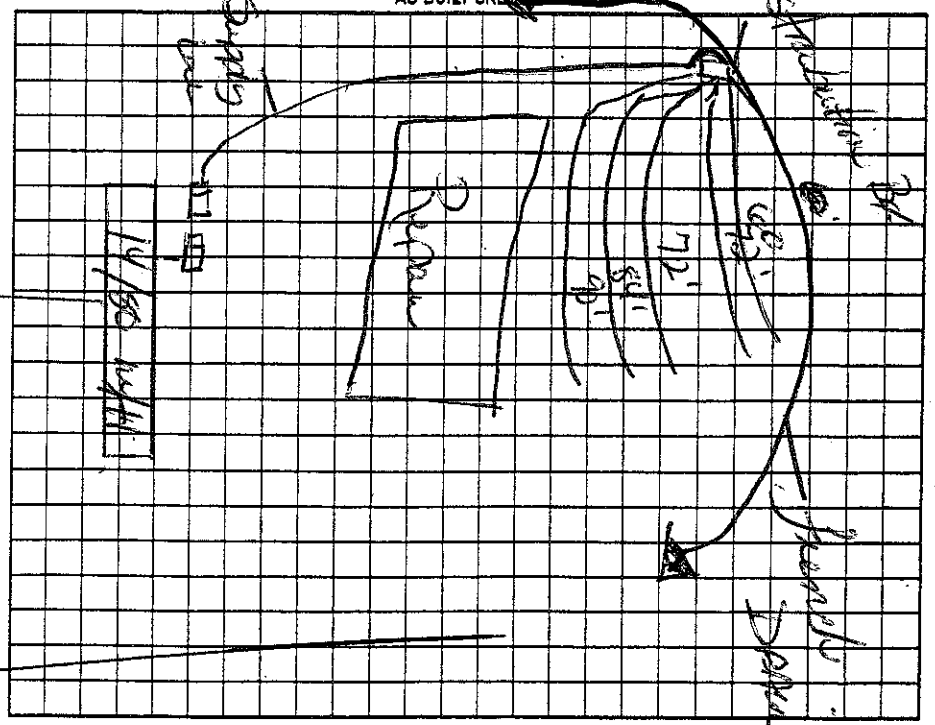

Permit can be suspended or revoked if any false information is supplied toward securing the permit/any unauthorized changes are made to the site/any unauthorized changes are made in the installation of the system. Improvement Permit with plat valid without expiration ☐ Improvement Permit with site plan valid for sixty months ☐ Authorization to Construct is valid for a period equal to that of Improvement Permit – not to exceed sixty months.

Signed: date Installed by:

Improvement Permit by: date Operation Permit by: date

Authorization to Construct by: date Existing System Inspection by: Kyle Cook date 2-20-08

HEALTH DEPT. COPY: WHITE OWNER COPY (FINAL): YELLOW OWNER COPY (INITIAL): PINK