47239

IREDELL COUNTY HEALTH DEPARTMENT

STATESVILLE 704-878-5305 MOORESVILLE 704-664-5281

IMPROVEMENT PERMIT / CERTIFICATE OF COMPLETION / OPERATION PERMIT / EXISTING SYSTEM INSPECTION

PROPERTY DESCRIPTION NO. 16316 DATE 8-9-93 TAX MAP NO. 5F-2-A-9

OWNER OR CONTRACTOR Terry Saltz PHONE: Business Home

ADDRESS

LOCATION I77 S TL Hwy 70 TR Triplett Rd. Willow Ridge on L. Lot #9

SUBDIVISION Willow Ridge BLOCK / SECTION LOT #9 LOT AREA .93 acre SITE CLASS P.S. L.T.A.R. .3 gpd/ft²

Water Supply: ☐ Individual ☐ Community ☐ Public

Septic Tank: 1000 Gallons; STB 825 Date 7-1-93

Pump Tank: — Gallons; PT — Date —

Nitrification Field: No Fields 1 Square Feet 1200 Linear Feet 400'

No Lines 3 Trench Width 36" Trench Depth 24"-36" Gravel Depth 12"

☑ New System ☐ Repair System Type: I (II) II, IV, V, VI

System Description: Conventional, gravity

Repair System Description: " "

Maintenance Agreement Required: ☐ Yes ☑ No

☐ House/Mod. Home ☑ Mobile Home ☐ Business ☐ Other

No. Bedrooms 3 No. Bathrooms 2 No. Employees —

Garbage Disposal: ☐ Yes ☑ No

Auto. Dishwasher: ☐ Yes ☐ No

Auto. Washing Machine: ☑ Yes ☐ No


Other

☐ Slab ☑ Crawl Space ☐ Basement w/plumbing ☐ Basement wo/plumbing

Comments 100% Repair Area below system, conventional, gravity fed. Keep well 100' from any part of septic system, and no closer than 50'.

INITIAL SITE SKETCH

AS BUILT SKETCH

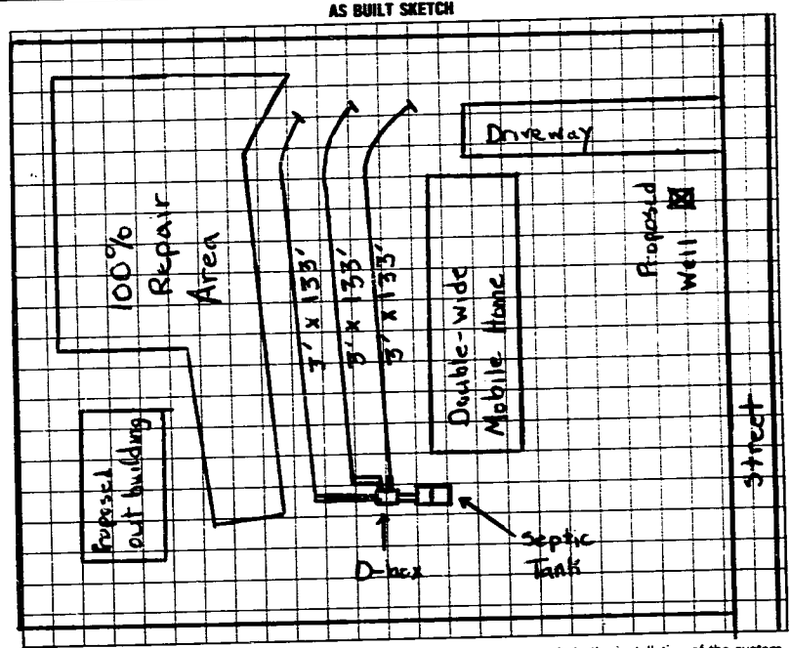

I understand that this permit can be suspended or revoked if any false information is supplied toward securing the permit/any unauthorized changes are made to the site/any unauthorized changes are made in the installation of the system Improvement Permit is valid for 60 months from date of issuance.

Signed:

Improvement Permit by: J.C. Moore date 5-13-93

Existing System Inspection by: date

Installed by: Wayne Potts

Certificate of Completion by: Michael L. Dennis date 8-9-13

Operation Permit by: date

HEALTH DEPT. COPY: WHITE INSPECTION COPY (FINAL): GREEN OWNER COPY (FINAL): YELLOW INSPECTION COPY (INITIAL): PINK OWNER COPY (INITIAL): GOLD