# IREDELL COUNTY HEALTH DEPARTMENT

STATESVILLE 704-878-5305 MOORESVILLE 704-664-5281

## IMPROVEMENT PERMIT / AUTHORIZATION TO CONSTRUCT / OPERATION PERMIT / EXISTING SYSTEM INSPECTION

PERMIT# 88100 PIN# 4771-36 5680 DATE 3-21-00

OWNER OR CONTRACTOR Rosario Aleman PHONE: Business Home 704 881 0131

ADDRESS 117 Winding Arbor Cr Cleveland N.C

LOCATION 7° E TR Triplett TL watermoss TR winding Arbor 2nd left

SUBDIVISION Willow Ridge BLOCK / SECTION LOT 43 LOT AREA .79 acres SITE CLASS P5 DESIGN FLOW 360 L.T.A.R. .33

Septic Tank: EX Gallons: STB Date

Pump Tank: Gallons: PT Date

Pump Make: Model Serial No.

Nitrification Field: No Fields 1 Square Feet 300 Linear Feet 100

No Lines 1 Trench Width 36" Max Trench Bottom Depth 36" Gravel Depth 12"

☐ New System ☒ Repair System Type: I. II. III. IV. V. VI

System Description: x addition Conv. Gravity

Repair System Description: Gravity 75% Repl.

Maintenance Agreement Required: ☐ Yes ☒ No

☐ House/Mod. Home ☒ Mobile Home ☐ Business ☐ Other

No. Bedrooms 3 No. Bathrooms 2 No. Employees


Water Supply: ☒ Individual ☐ Public ☐ Community

☐ Slab ☒ Crawl Space ☐ Basement w/plumbing ☐ Basement wo/plumbing


Comments /Conditions: Replacing 2 BR Home SW with 3 BR Home DW 220'

Comments /Conditions: original system For Lourdes Aleman Installed 3-11-93

INITIAL SITE SKETCH

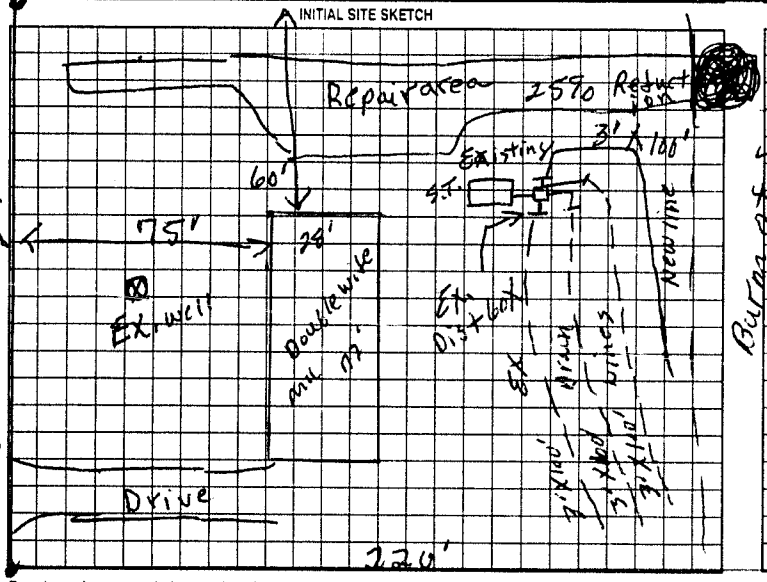


AS BUILT SKETCH

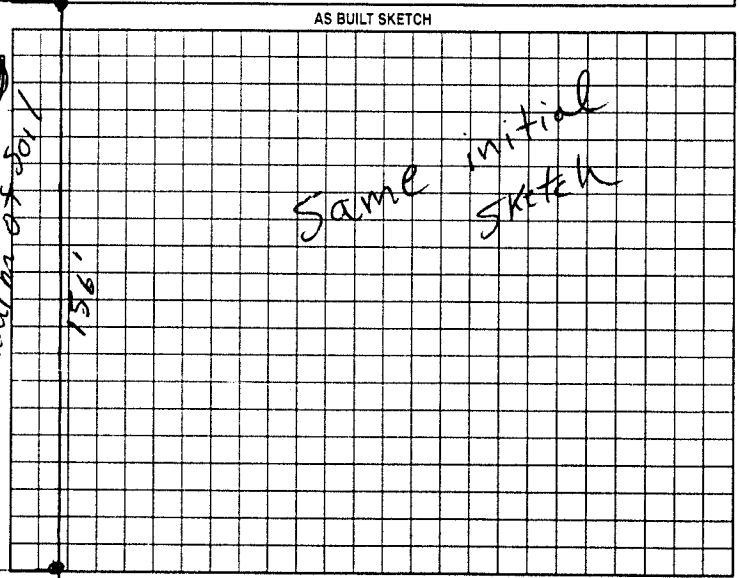


Permit can be suspended or revoked if any false information is supplied toward securing the permit/any unauthorized changes are made to the site/any unauthorized changes are made in the installation of the system. Improvement Permit with plat valid without expiration. Improvement Permit with site plan valid for sixty months. Authorization to Construct is valid for a period equal to that of Improvement Permit – not to exceed sixty months.

Signed: X. Rosario Aleman date 3/21/00 Installed by: Kanupp Grading

Improvement Permit by: P. C. Moore date 3/21/00 Operation Permit by: P. C. Moore date 3-27-00

Authorization to Construct by: P. C. Moore date 3/21/00 Existing System Inspection by: date

HEALTH DEPT. COPY: WHITE OWNER COPY (FINAL): YELLOW OWNER COPY (INITIAL): PINK