IREDELL COUNTY HEALTH DEPARTMENT

STATESVILLE 704-878-5305 MOORESVILLE 704-664-5281

52367

IMPROVEMENT PERMIT / CERTIFICATE OF COMPLETION / OPERATION PERMIT / EXISTING SYSTEM INSPECTION

PROPERTY DESCRIPTION NO. 18856 DATE 8-8-94 TAX MAP NO. 5F-2-A-55 Watershed: ☐ Yes ☒ No

OWNER OR CONTRACTOR Kevin Bryanson PHONE: Business 872 4131 Home

ADDRESS RT 8 BOX 682 Mooresville, N.C. 28115

LOCATION Hwy 70 E TR Triplett Rd TL water moss 1/4 mi left

SUBDIVISION Willow Ridge BLOCK / SECTION I LOT 55 LOT AREA 2.3 acres SITE CLASS. PS DESIGN FLOW 360 L.T.A.R. .35

Septic Tank: 1000 Gallons; STB 794 Date 7-7-94

Pump Tank: _____ Gallons; PT _____ Date _____

Pump Make: _____ Model _____ Serial No. _____

Nitrification Field: No Fields 1 Square Feet 1035 Linear Feet 345

No Lines 3 Trench Width 36 Max Trench Bottom Depth 36 Gravel Depth 12

☒ New System ☐ Repair System Type: I ☒ II, III, IV, V, VI

System Description: Conv. Gravity

Repair System Description: Pump To Conv. Lines

Maintenance Agreement Required: ☐ Yes ☒ No

☐ House/Mod. Home ☒ Mobile Home ☐ Business ☐ Other

No. Bedrooms 3 No. Bathrooms 2 No. Employees _____


☐ Slab ☒ Crawl Space ☐ Basement w/plumbing ☐ Basement wo/plumbing

Water Supply: ☒ Individual ☐ Community ☐ Public

Comments:

Comments: well Not located at Time of This inspection Keep drops distance from ST system & Repair area

INITIAL SITE SKETCH

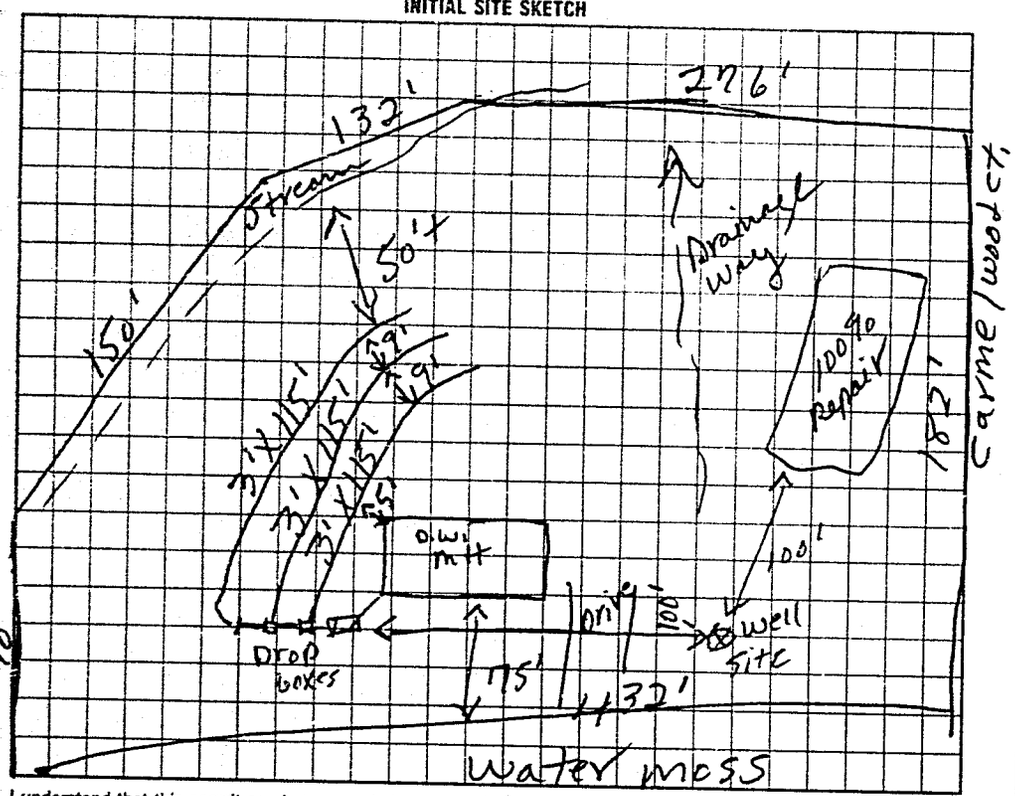

AS BUILT SKETCH

Same as initial sketch

I understand that this permit can be suspended or revoked if any false information is supplied toward securing the permit/any unauthorized changes are made to the site/any unauthorized changes are made in the installation of the system. Improvement Permit is valid for 60 months from date of issuance.

Signed: X Kevin J. Bryanson

Improvement Permit by: E. C. Moore date 8-8-94

Existing System Inspection by: _____ date _____

Installed by: Kenny Dellinger

Certificate of Completion by: E. C. Moore date 8-26-94

Operation Permit by: _____ date _____

HEALTH DEPT. COPY: WHITE INSPECTION COPY (FINAL): GREEN OWNER COPY (FINAL): YELLOW INSPECTION COPY (INITIAL): PINK OWNER COPY (INITIAL): GOLD