# IREDELL COUNTY HEALTH DEPARTMENT

STATESVILLE 704-878-5305 MOORESVILLE 704-664-5281

## IMPROVEMENT PERMIT / CERTIFICATE OF COMPLETION / OPERATION PERMIT / EXISTING SYSTEM INSPECTION

PROPERTY DESCRIPTION NO. 19511 DATE 10-14-94 TAX MAP NO. 5E-2-A-54 Watershed: ☐ Yes ☐ No

OWNER OR CONTRACTOR Kelly A. Osborne PHONE: Business Home 663-6358

ADDRESS 445 Stonewood Dr Apt n/o Mooresville

LOCATION 70E TR Triplett Rd Tb waterMoss Dr. Tb Carmelwood Ct on left

SUBDIVISION Willow Ridge BLOCK / SECTION LOT 54 LOT AREA 1.8 acres SITE CLASS. PS DESIGN FLOW 360 L.T.A.R. 135

Septic Tank: 1000 Gallons; STB 794 Date 9-13-94

Pump Tank: Gallons; PT Date

Pump Make: Model Serial No.

Nitrification Field: No Fields Square Feet 1035 Linear Feet 345

No Lines 4 Trench Width 36" Max Trench Bottom Depth 36" Gravel Depth

☑ New System ☐ Repair System Type: I, II, III, IV, V, VI

System Description: Conv. Gravity

Repair System Description: " "

Maintenance Agreement Required: ☐ Yes ☑ No

☐ Slab ☑ Crawl Space ☐ Basement w/plumbing ☐ Basement wo/plumbing

☐ House/Mod. Home No. Bedrooms 3

☑ Mobile Home No. Bathrooms 2

☐ Business No. Employees


☐ Other

Water Supply: ☑ Individual ☐ Community ☐ Public


Comments:

Comments: well & mobile Home not located on property at the time of this inspection. Keep proper distances from Septic Tank System as shown on sketch

INITIAL SITE SKETCH

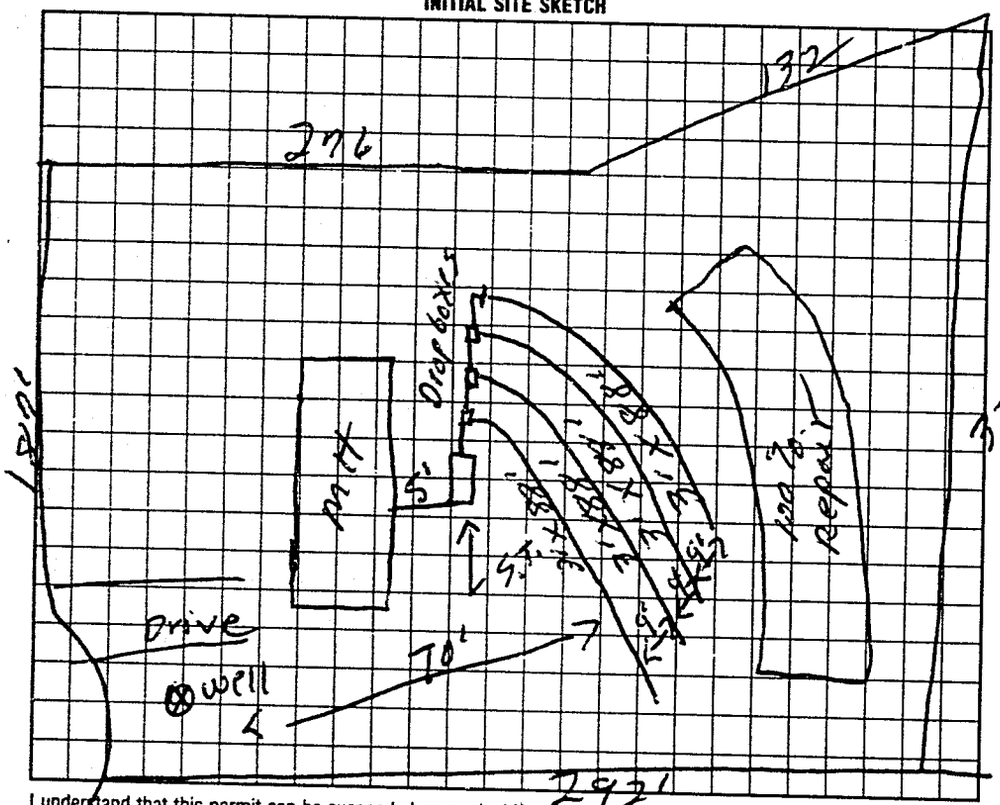


AS BUILT SKETCH

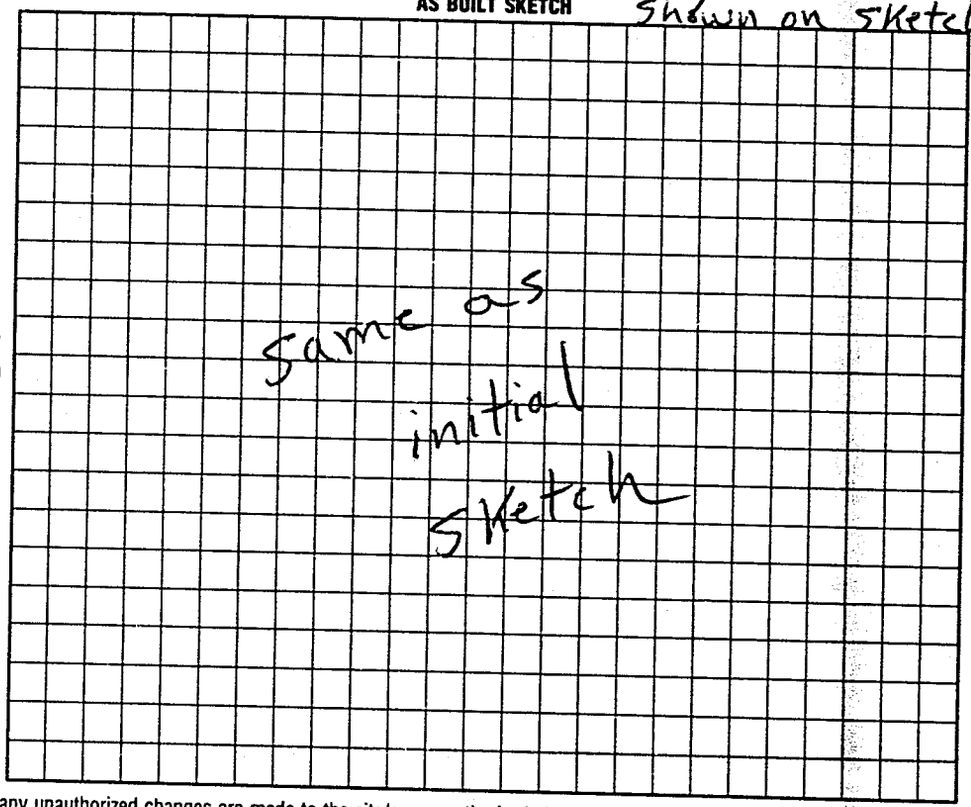


I understand that this permit can be suspended or revoked if any false information is supplied toward securing the permit/any unauthorized changes are made to the site/any unauthorized changes are made in the installation of the system. Improvement Permit is valid for 60 months from date of issuance.

Signed:

Improvement Permit by: R. C. Moore date 10-14-94

Existing System Inspection by: date

Installed by: Dellinger S.T. Co.

Certificate of Completion by: R. C. Moore date 11-8-94

Operation Permit by: date

HEALTH DEPT. COPY: WHITE INSPECTION COPY (FINAL): GREEN OWNER COPY (FINAL): YELLOW INSPECTION COPY (INITIAL): PINK OWNER COPY (INITIAL): GOLD