IREDELL COUNTY HEALTH DEPARTMENT

STATESVILLE 704-878-5305 MOORESVILLE 704-664-5281

IMPROVEMENT PERMIT / AUTHORIZATION TO CONSTRUCT / OPERATION PERMIT / EXISTING SYSTEM INSPECTION

PERMIT# 100407 PIN# 4771372573 DATE 3-22-10

OWNER OR CONTRACTOR Larry Trexler PHONE: Business _____ Home 704-528-7960

ADDRESS 187 Mt Jackson Rd Cleveland NC 27013

LOCATION 70E (R) Iredell (L) Watkinsville (R) Carmelwood Court on left

SUBDIVISION Willow Ridge BLOCK / SECTION 2 LOT 54/53 LOT AREA 1.19 SITE CLASS. C5 DESIGN FLOW 360 L.T.A.R. .35 (exist)

Septic Tank: 1000 Gallons; STB 794 Date 9-13-94

Pump Tank: _____ Gallons; PT _____ Date _____

Pump Make: _____ Model _____ Serial No. _____

Nitrification Field: No Fields 1 Square Feet 1035 Linear Feet 345

No Lines 3 Trench Width 36" Max Trench Bottom Depth 36" Gravel Depth _____

☐ ~~New System~~ ☐ Repair System Type: I, II, III, IV, V, VI

System Description: Conventional Trench

Repair System Description: 25% R

Maintenance Agreement Required: ☐ Yes ☒ No

☐ House/Mod. Home No. Bedrooms 3

☒ Mobile Home No. Bathrooms ____

☐ Business No. Employees ____

☐ Other _____


☐ Slab ☒ Crawl Space ☐ Basement w/plumbing ☐ Basement wo/plumbing

Water Supply:
☒ Individual
☐ Public
☐ Community

Comments:/Conditions:


NOT TO SCALE

INITIAL SITE SKETCH

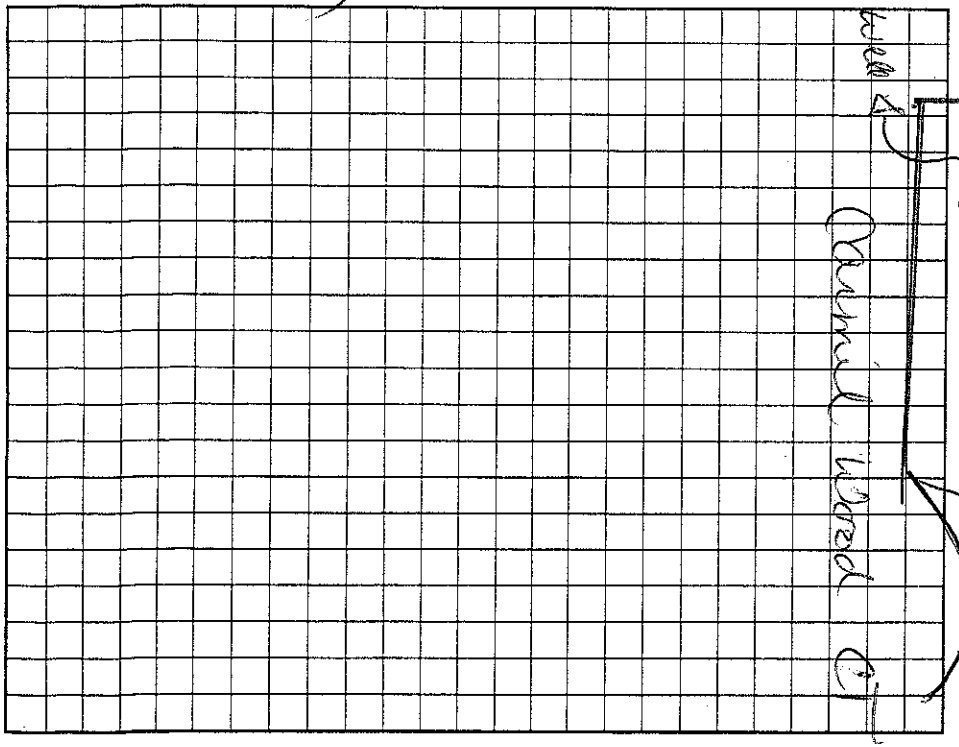

Comments:/Conditions:

AS BUILT SKETCH

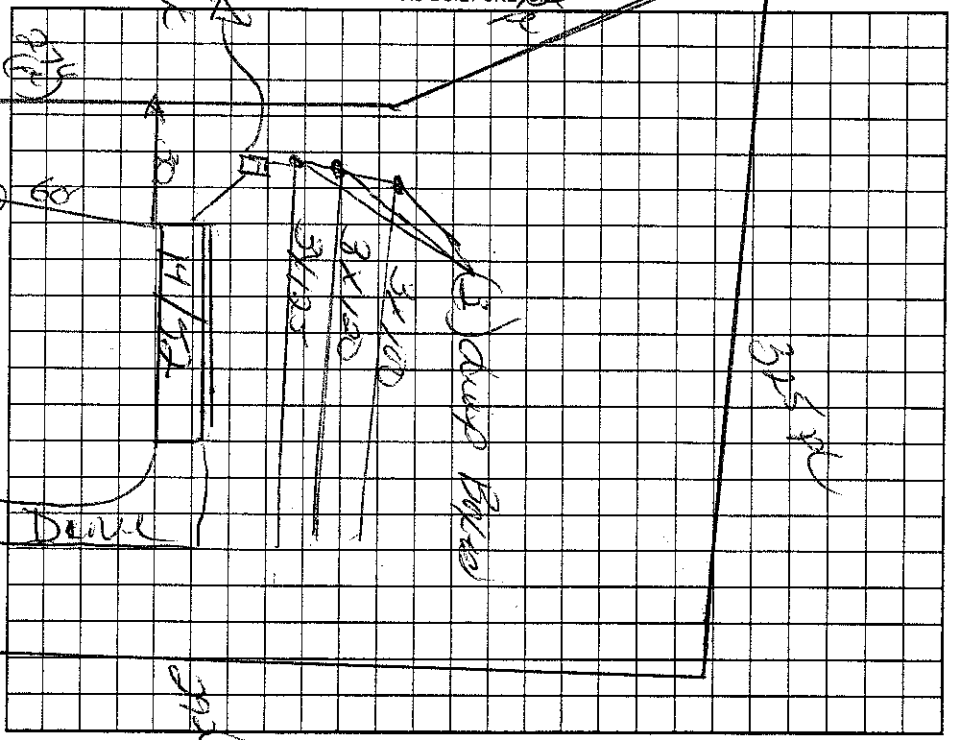

Permit can be suspended or revoked if any false information is supplied toward securing the permit/any unauthorized changes are made to the site/any unauthorized changes are made in the installation of the system. Improvement Permit with plat valid without expiration. Improvement Permit with site plan valid for sixty months. Authorization to Construct is valid for a period equal to that of Improvement Permit – not to exceed sixty months.

Signed: _____ date _____ Installed by: _____

Improvement Permit by: _____ date _____ Operation Permit by: _____ date _____

Authorization to Construct by: _____ date _____ Existing System Inspection by: Doug Cook date 3-22-10

HEALTH DEPT. COPY: WHITE OWNER COPY (FINAL): YELLOW OWNER COPY (INITIAL): PINK