4771425623

IREDELL COUNTY HEALTH DEPARTMENT

STATESVILLE 704-878-5305 MOORESVILLE 704-664-5281

IMPROVEMENT PERMIT / AUTHORIZATION TO CONSTRUCT / OPERATION PERMIT / EXISTING SYSTEM INSPECTION

PERMIT# 145003 PIN# 4771427727.000 DATE 9-24-07

OWNER OR APPLICANT Kenneth W. Kress II PHONE: Business 704-528-3191 Home 704-528-7665

ADDRESS 169 Cottonwood Rd

LOCATION Hwy 115 N TR Shinnville TR Oswalt Amity TR Cottonwood on left

SUBDIVISION _____ BLOCK / SECTION _____ LOT _____ LOT AREA 1.0 Ac SITE CLASS. PS DESIGN FLOW 360gpd L.T.A.R. .25 gpd / .2 repair

Septic Tank: 1000 Gallons: STB 794 Date 10/26/01
Pump Tank: _____ Gallons: PT _____ Date _____
Pump Make: _____ Model _____ Serial No. _____
Nitrification Field: No Fields 1 Square Feet 1080 Linear Feet 360
No Lines 4 Trench Width 36" Max Trench Bottom Depth 36"

☒ New System ☐ Repair ☐ Expansion System Type: I ☐ III IV V VI
System Description: 25% reduction gravity
Repair System Description: 25% reduction gravity
Maintenance Agreement Required: ☐ Yes ☒ No

☒ House/Mod. Home No. Bedrooms 3
☐ Mobile Home No. Persons 6
☐ Business No. Employees ____
☐ Other _____


Water Supply: ☑ Individual ☐ Public ☐ Community

Gravel Depth NA ☒ Gravity ☐ Pressure ☐ Slab ☒ Crawl Space ☐ Basement w/plumbing ☐ Basement wo/plumbing


Comments:/Conditions: House moved back 35' from where it was staked. House footprint drawn according to house plan.

Comments:/Conditions: Infiltrator installed

INITIAL SITE SKETCH 1"=50'

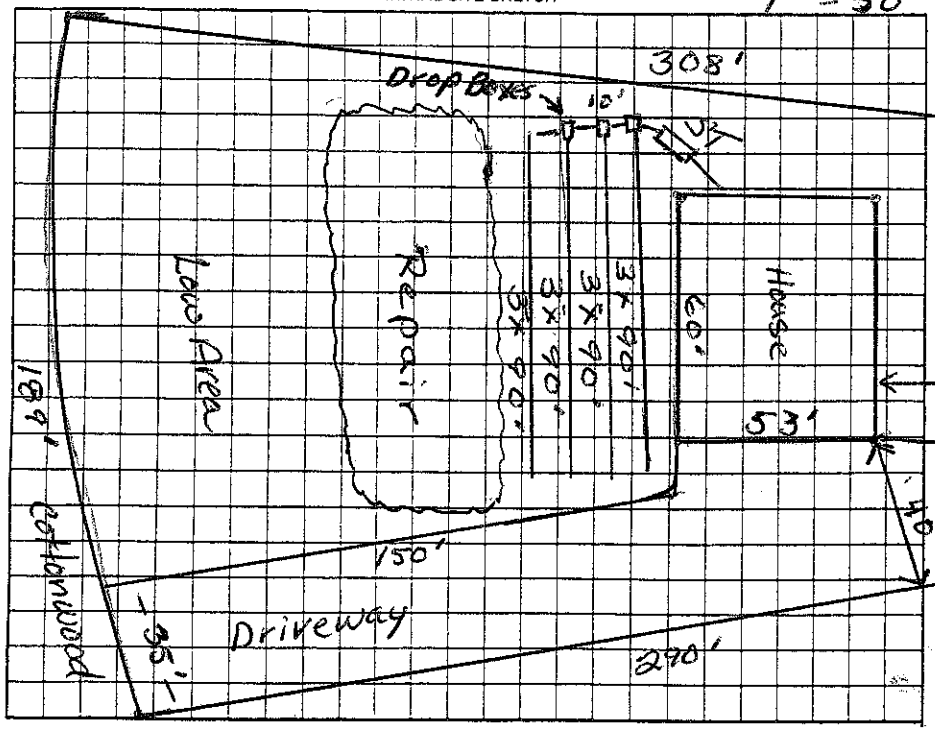

AS BUILT SKETCH

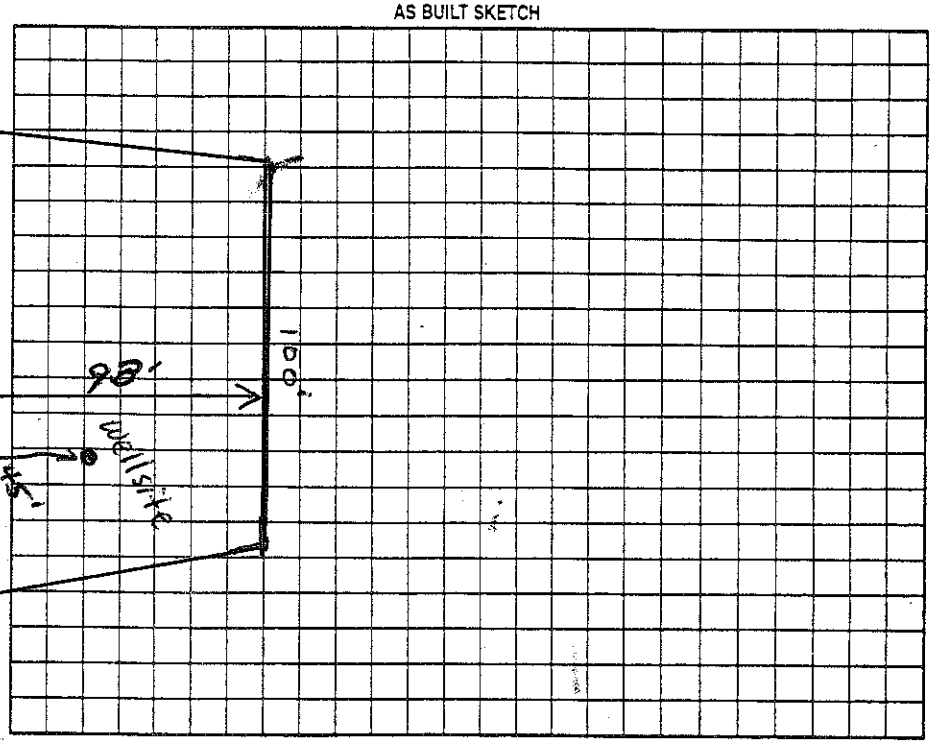

Permit can be suspended or revoked if any false information is supplied toward securing the permit/any unauthorized changes are made to the site/any unauthorized changes are made in the installation of the system. Improvement Permit with plat valid without expiration ☐ Improvement Permit with site plan valid for sixty months ☒ Authorization to Construct is valid for a period equal to that of Improvement Permit – not to exceed sixty months.

Signed: Kenneth W. Kress II date 9-26-07 Installed by: A-1

Improvement Permit by: Judy Melville date 9-24-07 Operation Permit by: Wesley Sparks RS date 11/30/07

Authorization to Construct by: Judy Melville date 9-24-07 Existing System Inspection by: _____ date _____

HEALTH DEPT. COPY: WHITE OWNER COPY (FINAL): YELLOW OWNER COPY (INITIAL): PINK