4771433481

IREDELL COUNTY HEALTH DEPARTMENT

STATESVILLE 704-878-5305 MOORESVILLE 704-664-5281

IMPROVEMENT PERMIT / CERTIFICATE OF COMPLETION / OPERATION PERMIT / EXISTING SYSTEM INSPECTION

PROPERTY DESCRIPTION NO. 21295 DATE 6/8/95 TAX MAP NO. 5A A 23 pt of F, Watershed: ☐ Yes ☒ No

OWNER OR CONTRACTOR Larry Frazier PHONE: Business Home 528-7556

ADDRESS 189 Mt Tabor Rd. Cleveland, NC 27013

LOCATION Oswalt Amity Rd. on (R) at intersection of Cottonwood Rd.

SUBDIVISION Welwyn East BLOCK / SECTION LOT 1 LOT AREA .+.1AC SITE CLASS. P DESIGN FLOW 360 L.T.A.R. .3

Septic Tank: 1600 Gallons; STB 794 Date 4/11/95

Pump Tank: Gallons; PT Date

Pump Make: Model Serial No.

Nitrification Field: No Fields 1 Square Feet 1200 Linear Feet 300 (400)

No Lines 5 Trench Width 36" Max Trench Bottom Depth 32" Gravel Depth N/A

☒ New System ☐ Repair System Type: I, II, (III), IV, V, VI

System Description: INFILTRATOR - DIST BOX

Repair System Description: PANEL

Maintenance Agreement Required: ☐ Yes ☒ No

☐ House/Mod. Home ☒ Mobile Home ☐ Business ☐ Other

No. Bedrooms 3 No. Bathrooms 2 No. Employees

☐ Slab ☒ Crawl Space ☐ Basement w/plumbing ☐ Basement wo/plumbing


Water Supply: ☒ Individual ☐ Community ☐ Public

Comments:

Comments:

Installed as drawn

INITIAL SITE SKETCH

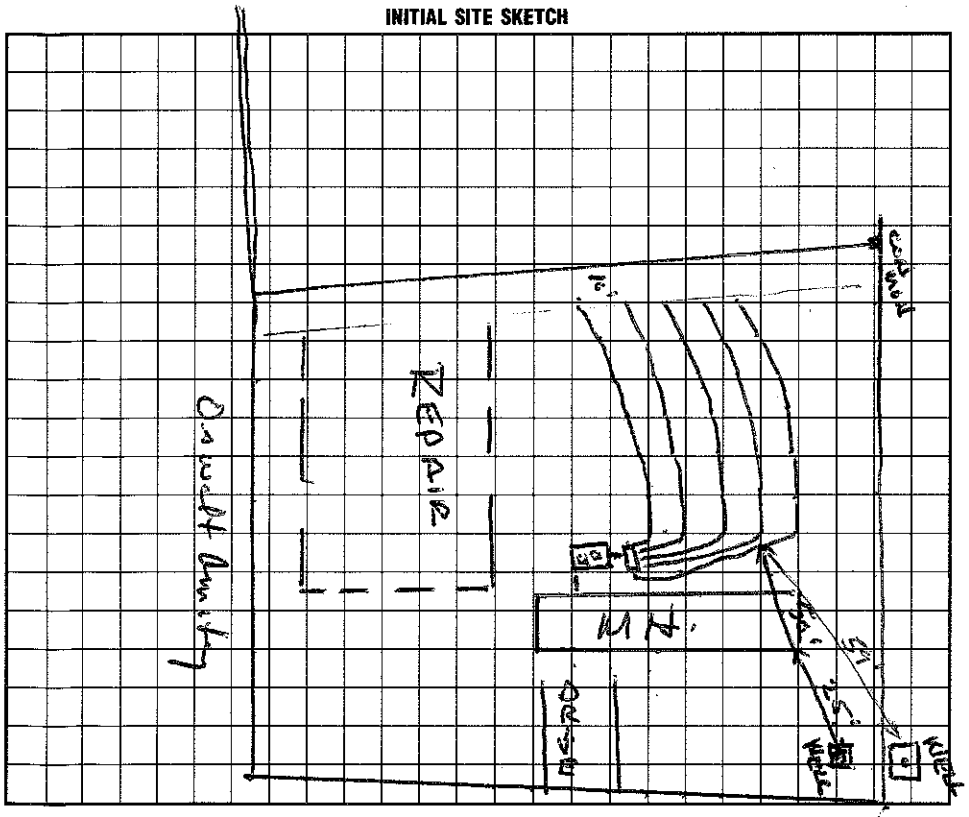

AS BUILT SKETCH

I understand that this permit can be suspended or revoked if any false information is supplied toward securing the permit/any unauthorized changes are made to the site/any unauthorized changes are made in the installation of the system. Improvement Permit is valid for 60 months from date of issuance.

Signed: X Larry Frazier

Improvement Permit by: Wesley Sparks R.S. date 6/8/95

Existing System Inspection by: date

Installed by: F J Erwin

Certificate of Completion by: Wesley Sparks R.S. date 6/16/95

Operation Permit by: date

HEALTH DEPT. COPY: WHITE INSPECTION COPY (FINAL): GREEN OWNER COPY (FINAL): YELLOW INSPECTION COPY (INITIAL): PINK OWNER COPY (INITIAL): GOLD