IREDELL COUNTY HEALTH DEPARTMENT - ENVIRONMENTAL HEALTH ☑ STATESVILLE OFFICE 704-878-5300

IMPROVEMENT PERMIT / AUTHORIZATION TO CONSTRUCT / OPERATION PERMIT / EXISTING SYSTEM INSPECTION

DATE 8-27-12

PERMIT # 174373 PIN # 4771433678 APPLICANT: Same PHONE: Home/Cell # 704-528-2385 Business # N/A

OWNER Junius Christy OWNER / APPLICANT ADDRESS 125 Cottonwood Rd. Cleveland

SITE ADDRESS 1585 Ostwalt Amity Rd. Cleveland

SITE DIRECTIONS Hwy 21 S TL Ostwalt Amity ~8-10 miles on Left

SUBDIVISION N/A BLOCK / SECTION N/A LOT # N/A LOT AREA 1.48 acres DESIGN FLOW 480 gpd L.T.A.R. Existing

Septic Tank Existing Gallons: STB ____ Date ____

Pump Tank Existing Gallons: PT ____ Date ____

Pump Make Goulds Model WE05(1)H Serial # ____

No. Nitrification Fields: 1 No. Lines 5 Linear Feet Existing

Trench Width 36" Max. Trench Bottom Depth Ex

☐ New System ☐ Repair ☑ Expansion System Type I II III IV V VI

System Description: Pump Conventional

Repair System Description: Maximum feasible: 15A NCAC 18A .1945 (d)

Maintenance Agreement Required ☐ YES ☑ NO

☐ GRAVITY ☑ PRESSURE Gravel Depth Ex.

☑ Residence ☐ Business ☐ Other ☐ Slab


No. Bedrooms 4 No. Persons ____ No. Employees ____

☑ Basement w/plumbing ☐ Basement w/o plumbing ☐ Crawl Space

Water Supply: ☑ Private ☐ Public ☐ Community

Comments / Conditions - Combine two existing systems together as shown below. - Pump must be capable of 21 gpm @ TDH 20'. Extend Riser a minimum of 6" above grade. Install Control panel to meet .1952 C & I

INITIAL SITE SKETCH

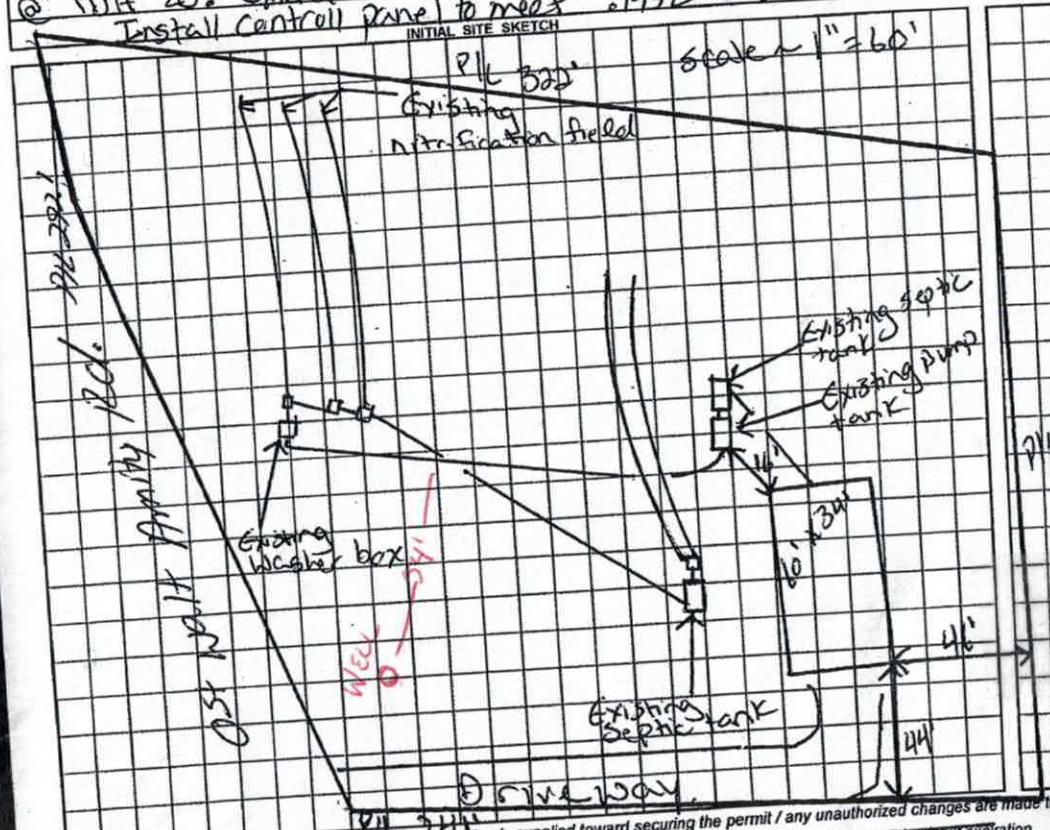

AS BUILT SKETCH

	Date	Initials
Drain Lines Checked		
Tanks Checked	8-21	BA
Pressure Manifold or Valve Box Checked	8-21	BA
Pressure Head Set	8-21	BA
Electrical Checked	8-23	BA
Floats Set	8-21	BA
Alarm Checked	8-23	BA
Maintenance Contract Y / N	Not Required	

Permit can be suspended or revoked if any false information is supplied toward securing the permit / any unauthorized changes are made to the site / any unauthorized changes are made in the installation of the system.

☐ *IMPROVEMENT PERMIT with plat valid without expiration.* ☑ *IMPROVEMENT PERMIT with plat valid without expiration. site plan valid 60 mo.* ☑ *AUTHORIZATION TO CONSTRUCT valid for period equal to IMPROVEMENT PERMIT--not to exceed 60 mo.*

Owner / Applicant Signature: Junius Christy Date 8-31-12 Installed by: FJ ERVIN

IMPROVEMENT PERMIT by: Justin Henderson REHS Date 8-27-12 OPERATION PERMIT by: BA REHS Date 8-23-17

AUTHORIZATION TO CONSTRUCT by: Justin Henderson REHS Date 8-27-12 Existing System Inspected by: ____ REHS Date ____

YOU SHOULD CONTACT A LOCATOR SERVICE PRIOR TO ANY EXCAVATION

White Copy -- Environmental Health YELLOW COPY (Final) Owner / Applicant PINK COPY (Initial) Owner / Applicant