IREDELL COUNTY HEALTH DEPARTMENT

STATESVILLE 704-878-5305 MOORESVILLE 704-664-5281

4771436086

IMPROVEMENT PERMIT / CERTIFICATE OF COMPLETION / OPERATION PERMIT / EXISTING SYSTEM INSPECTION

PROPERTY DESCRIPTION NO. 19518 DATE 10/7/94 TAX MAP NO. 5A-A-43 Watershed: ☐ Yes ☒ No

OWNER OR CONTRACTOR JAMES CORNETT PHONE: Business _____ Home 528-4444

ADDRESS 119 COTTONWOOD RD. CLEVELAND NC 27013

LOCATION Cottonwood Rd. OS Amity past Triplett Rd. TR on COTTONWOOD RD. 2ND drive on ©

SUBDIVISION N/A BLOCK / SECTION _____ LOT _____ LOT AREA ~3AC SITE CLASS. P DESIGN FLOW 360 L.T.A.R. .25

Septic Tank: 1000 Gallons; STB 825 Date 7/1/94

Pump Tank: _____ Gallons; PT _____ Date _____

Pump Make: _____ Model _____ Serial No. _____

Nitrification Field: No Fields 1 Square Feet 1440 Linear Feet 480

No Lines 4 Trench Width 36" Max Trench Bottom Depth 30" Gravel Depth _____

☒ New System ☐ Repair System Type: I, ☒ II, III, IV, V, VI

System Description: CONV - DROP BOXES

Repair System Description: _____

Maintenance Agreement Required: ☐ Yes ☒ No

☐ House/Mod. Home No. Bedrooms 3

☒ Mobile Home No. Bathrooms 1

☐ Business No. Employees _____

☐ Other _____


☐ Slab ☐ Crawl Space ☐ Basement w/plumbing ☐ Basement wo/plumbing

Water Supply: ☒ Individual ☐ Community ☐ Public

Comments: Maximum trench depth 28" ; ON CONTOUR

Comments: Installed as per approved Permit

INITIAL SITE SKETCH

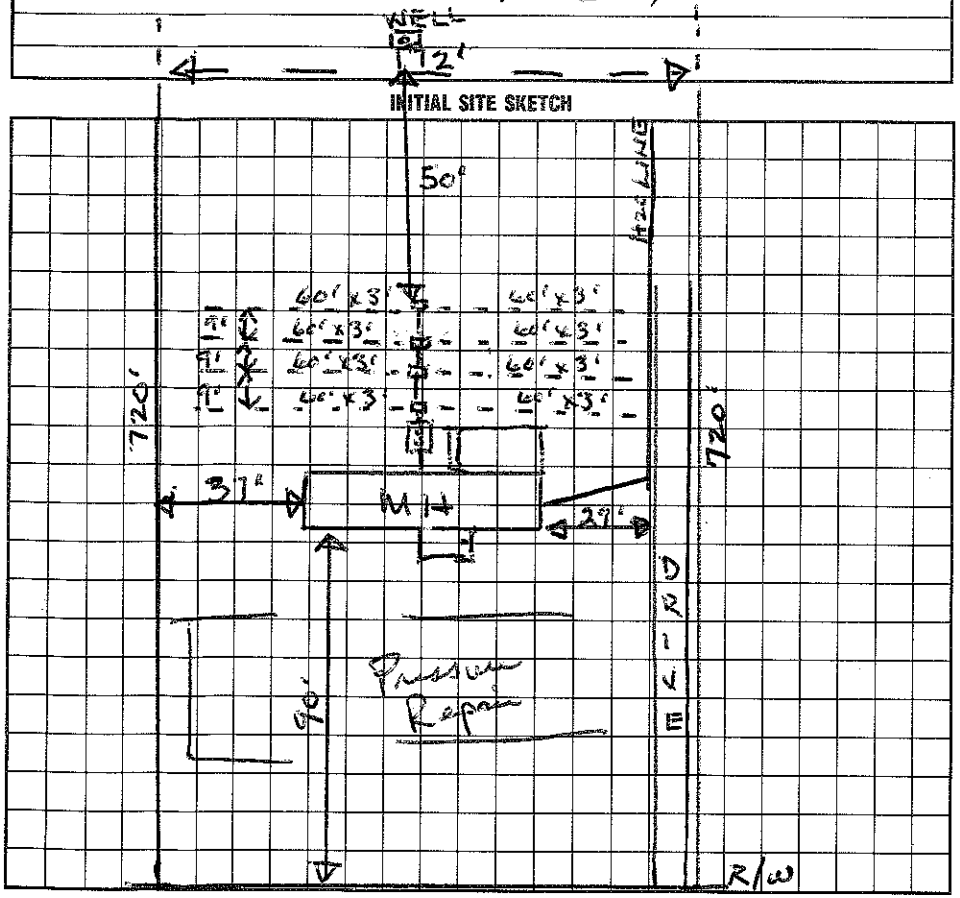

AS BUILT SKETCH

I understand that this permit can be suspended or revoked if any false information is supplied toward securing the permit/any unauthorized changes are made to the site/any unauthorized changes are made in the installation of the system. Improvement Permit is valid for 60 months from date of issuance.

Signed: James Burnett Cornett

Improvement Permit by: Wesley Sparks R.S. date 10/7/94

Existing System Inspection by: _____ date _____

Installed by: Lashstone

Certificate of Completion by: Wesley Sparks R.S. date 10/28/94

Operation Permit by: _____ date _____

HEALTH DEPT. COPY: WHITE INSPECTION COPY (FINAL): GREEN OWNER COPY (FINAL): YELLOW INSPECTION COPY (INITIAL): PINK OWNER COPY (INITIAL): GOLD