IREDELL COUNTY HEALTH DEPARTMENT

STATESVILLE 704-878-5305 MOORESVILLE 704-664-5281

IMPROVEMENT PERMIT / AUTHORIZATION TO CONSTRUCT / OPERATION PERMIT / EXISTING SYSTEM INSPECTION

PERMIT# 104219 PIN# 4771436455 DATE 1/22/2002

OWNER OR CONTRACTOR Oakwood Homes (Larry Freeze) PHONE: Business (704) 528-4516 Drew Home

ADDRESS 1042 Charlotte Hwy Statesman, NC 28169

LOCATION 1590 Ostwalt Amity Rd. Hwy 21 N TR Ostwalt Amity Rd ~ 7 miles on RT

SUBDIVISION Wellwyn Est BLOCK / SECTION J LOT 3 LOT AREA .75 Acre SITE CLASS. PS DESIGN FLOW 360gpd L.T.A.R.

Septic Tank: Existing Gallons; STB Date

Pump Tank: Gallons; PT Date

Pump Make: Model Serial No.

Nitrification Field: No Fields Existing Square Feet Linear Feet

No Lines Trench Width Max Trench Bottom Depth Gravel Depth

☐ New System ☐ Repair System Type: I II III IV V VI

System Description: Existing Gravity-Conventional

Repair System Description:

Maintenance Agreement Required: ☐ Yes ☒ No

☐ House/Mod. Home No. Bedrooms 3

☒ Mobile Home No. Bathrooms 2

☐ Business No. Employees

☐ Other

☐ Slab ☒ Crawl Space ☐ Basement w/plumbing ☐ Basement wo/plumbing

Water Supply: ☐ Individual ☒ Public ☒ Community


Comments:/Conditions: Existing Septic System appears to be functioning okay at time of inspection, No problems noticed.

Comments:/Conditions:

INITIAL SITE SKETCH

AS BUILT SKETCH

☆ Not to Scale

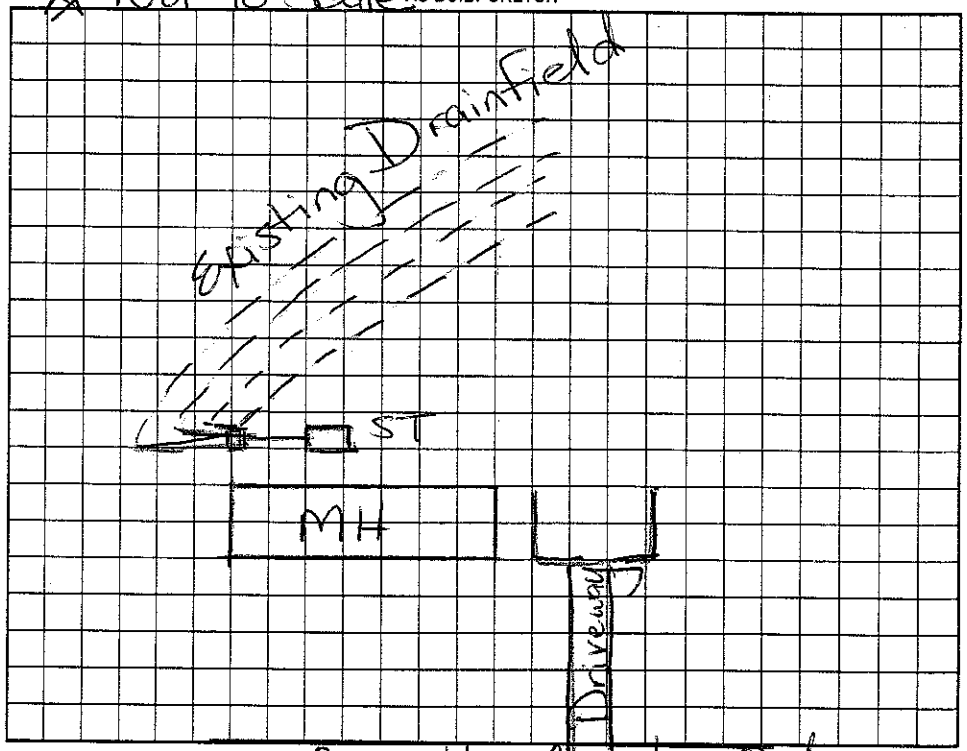

Permit can be suspended or revoked if any false information is supplied toward securing the permit/any unauthorized changes are made to the site/any unauthorized changes are made in the installation of the system. Improvement Permit with plat valid without expiration. Improvement Permit with site plan valid for sixty months. Authorization to Construct is valid for a period equal to that of Improvement Permit – not to exceed sixty months.

Signed: ~~George A Raynor~~ date Installed by:

Improvement Permit by: Maria H Dotson RS date 1/22/2002 Operation Permit by: date

Authorization to Construct by: date Existing System Inspection by: Maria H Dotson RS date 1/22/2002

HEALTH DEPT. COPY: WHITE OWNER COPY (FINAL): YELLOW OWNER COPY (INITIAL): PINK