IREDELL COUNTY HEALTH DEPARTMENT

STATESVILLE 704-878-5305 MOORESVILLE 704-664-5281

IMPROVEMENT PERMIT / AUTHORIZATION TO CONSTRUCT / OPERATION PERMIT / EXISTING SYSTEM INSPECTION

PERMIT# 10473170 PIN# 4771437486 DATE 2-11-2002

OWNER OR CONTRACTOR Larry Freeze PHONE: Business 528-9556 Home

ADDRESS 187 Mt. J Tabor Rd. Cleveland, NC

LOCATION Oswalt Amity Rd. Pass Cottonwood 4th on RT

SUBDIVISION Wellwyn Est BLOCK / SECTION LOT 4 LOT AREA .94 Acre SITE CLASS. PS DESIGN FLOW 360gpd T.A.R.

Existing Septic Tank: 1600 Gallons; STB Date

Pump Tank: Gallons; PT Date

Pump Make: Model Serial No.

Nitrification Field: No Fields 1 Square Feet 1200' Linear Feet 400'

No Lines 4@100 Trench Width 36" Max Trench Bottom Depth Gravel Depth 12"

☐ New System ☐ Repair System Type: (I, II, III, IV, V, VI)

System Description: Existing Gravity Conventional

Repair System Description: Same

Maintenance Agreement Required: ☐ Yes ☒ No

☐ House/Mod. Home ☒ Mobile Home ☐ Business ☐ Other

No. Bedrooms 3 No. Bathrooms 2 No. Employees


☐ Slab ☒ Crawl Space ☐ Basement w/plumbing ☐ Basement wo/plumbing

Water Supply: ☐ Individual ☐ Public ☒ Community


Comments:/Conditions: Existing Septic System Appears to be functioning okay at time of inspection

Comments:/Conditions: Originally installed 6/14/95

INITIAL SITE SKETCH ✱ Not to Scale

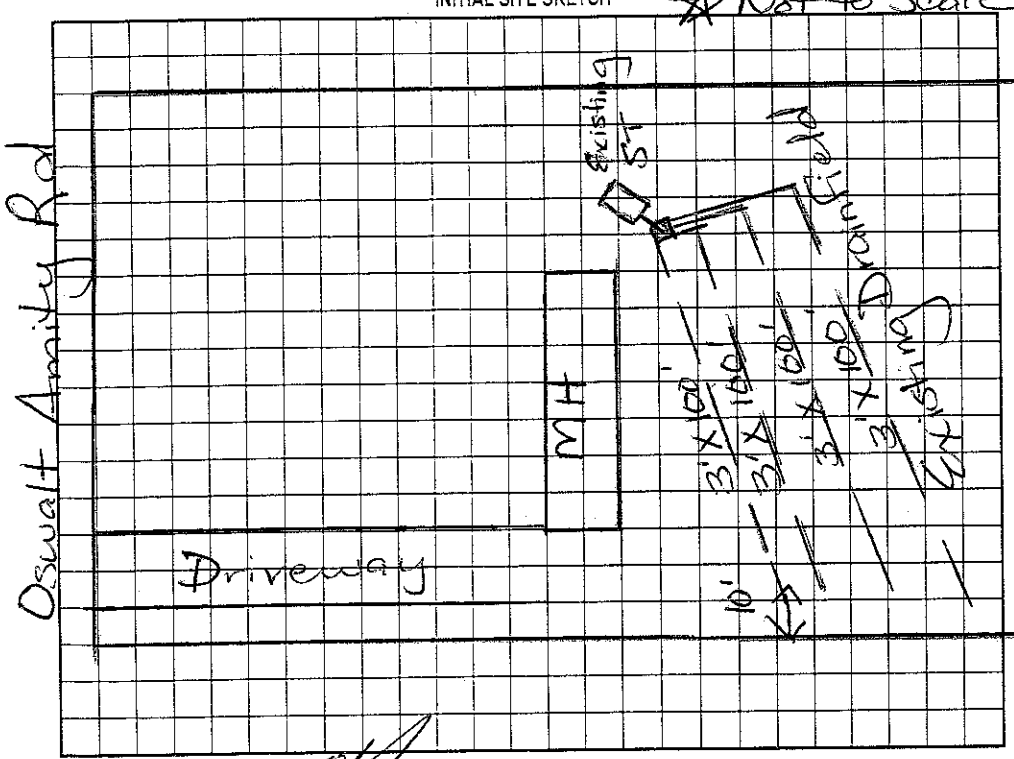

AS BUILT SKETCH

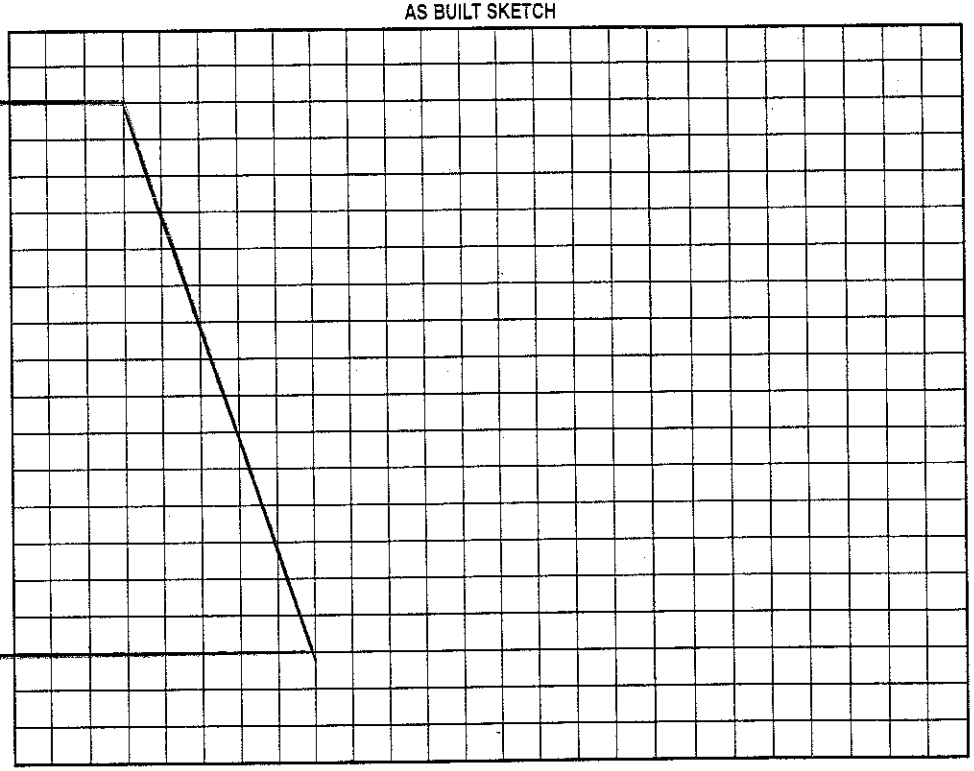

Permit can be suspended or revoked if any false information is supplied toward securing the permit/any unauthorized changes are made to the site/any unauthorized changes are made in the installation of the system. Improvement Permit with plat valid without expiration. Improvement Permit with site plan valid for sixty months. Authorization to Construct is valid for a period equal to that of Improvement Permit – not to exceed sixty months.

Signed: date Installed by:

Improvement Permit by: date 2/11/2002 Operation Permit by: date

Authorization to Construct by: date Existing System Inspection by: date 2/11/2002

HEALTH DEPT. COPY: WHITE OWNER COPY (FINAL): YELLOW OWNER COPY (INITIAL): PINK