IREDELL COUNTY HEALTH DEPARTMENT

STATESVILLE 704-878-5305 MOORESVILLE 704-664-5281

IMPROVEMENT PERMIT / AUTHORIZATION TO CONSTRUCT / OPERATION PERMIT / EXISTING SYSTEM INSPECTION

PERMIT# 97644 PIN# 4771448904 DATE 11-17-98

OWNER OR CONTRACTOR Michael Shrewsbury PHONE: Business Home 528 5614

ADDRESS 195 Barksdale Rd Troutman N.C.

LOCATION 115 S TL Oswalt Amity 1/4 mile past Triplett on left

SUBDIVISION BLOCK / SECTION LOT LOT AREA 7.85 acres SITE CLASS 1 2 5 DESIGN FLOW 480 L.T.A.R. .35

Septic Tank: 1000 Gallons; STB 1012 Date 4-28-97

Pump Tank: Gallons; PT Date

Pump Make: Model Serial No.

Nitrification Field: No Fields 1 Square Feet 1350 Linear Feet 450

No Lines 3 Trench Width 36" Max Trench Bottom Depth 36" Gravel Depth 12"

☑ New System ☐ Repair System Type: I, II, III, IV, V, VI

System Description: Conv. Gravity

Repair System Description: " "

Maintenance Agreement Required: ☐ Yes ☑ No

☑ House/Mod. Home No. Bedrooms 4

☐ Mobile Home No. Bathrooms 2

☐ Business No. Employees

☐ Other


☐ Slab ☐ Crawl Space ☐ Basement w/plumbing ☐ Basement wo/plumbing

Water Supply: ☑ Individual ☐ Public ☐ Community


Comments:/Conditions:

Comments:/Conditions:

INITIAL SITE SKETCH

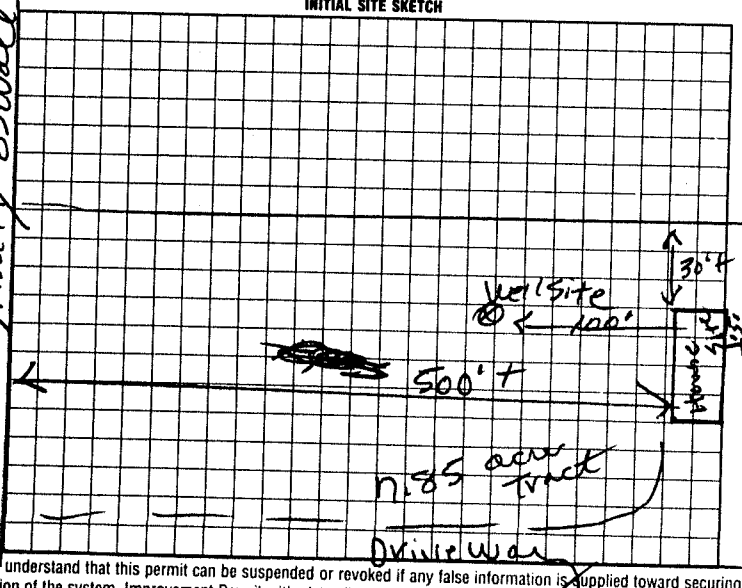

AS BUILT SKETCH

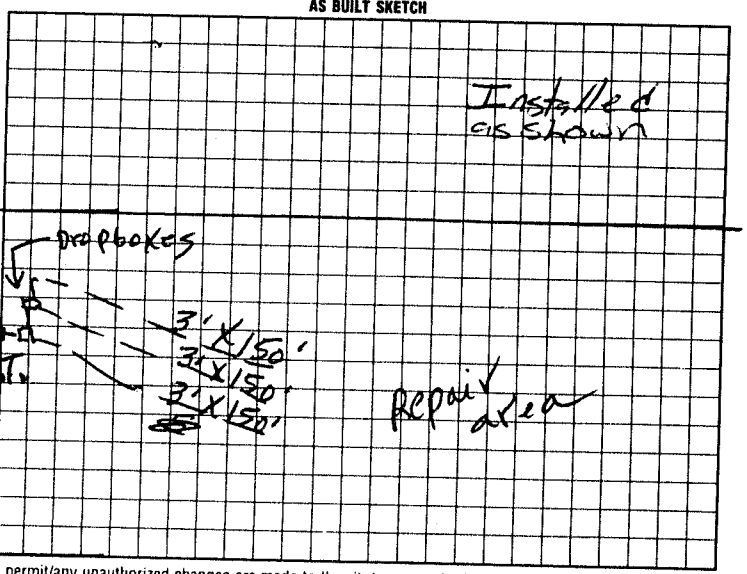

I understand that this permit can be suspended or revoked if any false information is supplied toward securing the permit/any unauthorized changes are made to the site/any unauthorized changes are made in the installation of the system. Improvement Permit with plat valid without expiration. Improvement Permit with site plan valid for sixty months. Authorization to Construct is valid for a period equal to that of Improvement Permit – not to exceed sixty months.

Signed: Melissa B. Shrewsbury date 11-17-98 Installed by: Steve Jordan

Improvement Permit by: R. C. Moore date 11-17-98 Operation Permit by: [illegible] RS date 6-23-99

Authorization to Construct by: R. C. Moore date 11-17-98 Existing System Inspection by: date

HEALTH DEPT. COPY: WHITE INSPECTION COPY (FINAL): GREEN OWNER COPY (FINAL): YELLOW INSPECTION COPY (INITIAL): PINK OWNER COPY (INITIAL): GOLD