IREDELL COUNTY HEALTH DEPARTMENT

STATESVILLE 704-878-5305 MOORESVILLE 704-664-5281

IMPROVEMENT PERMIT / AUTHORIZATION TO CONSTRUCT / OPERATION PERMIT / EXISTING SYSTEM INSPECTION

PERMIT# 78183 PIN# 4771 44 8904 DATE 12-30-98

OWNER OR CONTRACTOR Michael Shrewsbury PHONE: Business 528 5614 Home

ADDRESS 195 Parkdale Rd / Trout man N.C.

LOCATION 115 S TO Oswalt Amity 1/4 mi on left past Triplett Rd on left

SUBDIVISION BLOCK / SECTION LOT LOT AREA 7.85 acres SITE CLASS PS DESIGN FLOW 360 L.T.A.R. .133

Septic Tank: 1000 Gallons; STB 1017 Date 4-24-99

Pump Tank: Gallons; PT Date

Pump Make: Model Serial No.

Nitrification Field: No Fields 1 Square Feet 1080 Linear Feet 360

No Lines 4 Trench Width 36" Max Trench Bottom Depth 36" Gravel Depth 12"

☐ New System ☐ Repair System Type: I II III IV V VI

System Description: Conv. Gravity

Repair System Description: " "

Maintenance Agreement Required: ☐ Yes ☒ No

☐ Slab ☒ Crawl Space ☐ Basement w/plumbing ☐ Basement wo/plumbing

☐ House/Mod. Home No. Bedrooms 3

☐ Mobile Home No. Bathrooms 2

☐ Business No. Employees

☐ Other


Water Supply: ☐ Individual ☐ Public ☐ Community

Comments/Conditions:


Comments/Conditions

2000'+

INITIAL SITE SKETCH

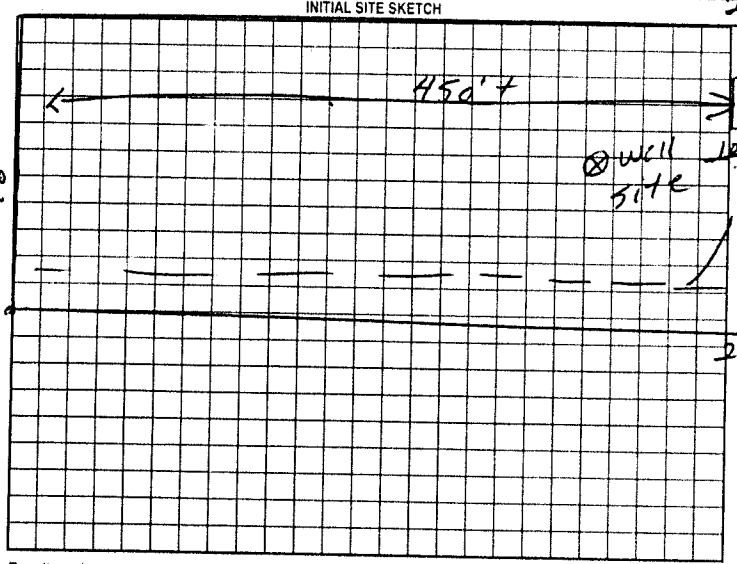

AS BUILT SKETCH

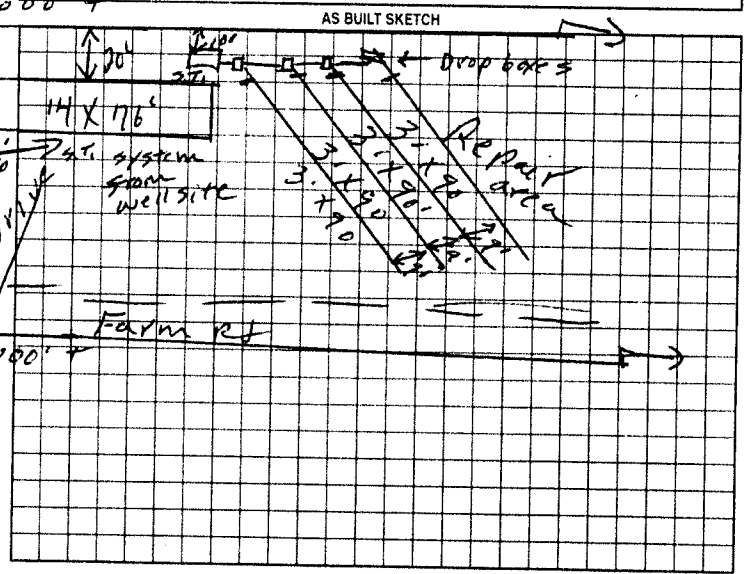

Permit can be suspended or revoked if any false information is supplied toward securing the permit/any unauthorized changes are made to the site/any unauthorized changes are made in the installation of the system. Improvement Permit with plat valid without expiration. Improvement Permit with site plan valid for sixty months. Authorization to Construct is valid for a period equal to that of Improvement Permit – not to exceed sixty months.

Signed: M. Shrewsbury date Installed by: Steve Ingram

Improvement Permit by: L. C. Moore date 12-30-98 Operation Permit by: Mary Coty RS date 6-23-99

Authorization to Construct by: L. C. Moore date 12-30-98 Existing System Inspection by: date

HEALTH DEPT. COPY WHITE OWNER COPY (FINAL) YELLOW OWNER COPY (INITIAL) PINK

Oswalt 96 Amity Rd