Oakwood Homes 48974

IREDELL COUNTY HEALTH DEPARTMENT

STATESVILLE 704-878-5305 MOORESVILLE 704-664-5281

IMPROVEMENT PERMIT / CERTIFICATE OF COMPLETION / OPERATION PERMIT / EXISTING SYSTEM INSPECTION

PROPERTY DESCRIPTION NO. 17 | 25 DATE 10-1-93 TAX MAP NO. SF 2-4-74

OWNER OR CONTRACTOR Carlton Stoots PHONE: Business 528-9449 Home

ADDRESS

LOCATION 70E TR Triplett TL water moss TL morcroft 1ST mH on RT L.T.A.R. .3

SUBDIVISION Willow Ridge BLOCK / SECTION 2 LOT 74 LOT AREA 3/4acre SITE CLASS. PS 6

Water Supply: ☐ Individual ☐ Community ☐ Public

Septic Tank: 1000 Gallons; STB 794 Date 8-10-93

Pump Tank: Gallons; PT Date

Nitrification Field: No Fields 1 Square Feet 1200 Linear Feet 400

No Lines 4 Trench Width 36 Trench Depth 18&36 Gravel Depth 12"

☐ New System ☐ Repair System Type: I, II, III, IV, V, VI

System Description: Conv Gravity

Repair System Description: ~~Gravity Press~~ Block Panel

Maintenance Agreement Required: ☐ Yes ☐ No

☐ House/Mod. Home ☐ Mobile Home ☐ Business ☐ Other

No. Bedrooms 3 No. Bathrooms 2 No. Employees

☐ Slab ☐ Crawl Space ☐ Basement w/plumbing ☐ Basement wo/plumbing

Garbage Disposal: ☐ Yes ☐ No


Auto. Dishwasher: ☐ Yes ☐ No

Auto. Washing Machine: ☐ Yes ☐ No


Other

Comments

INITIAL SITE SKETCH

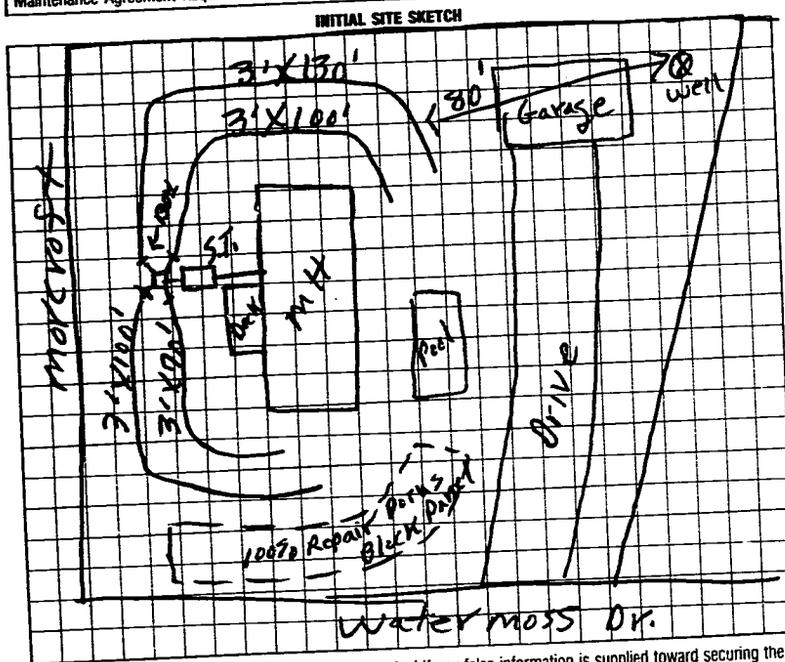

AS BUILT SKETCH

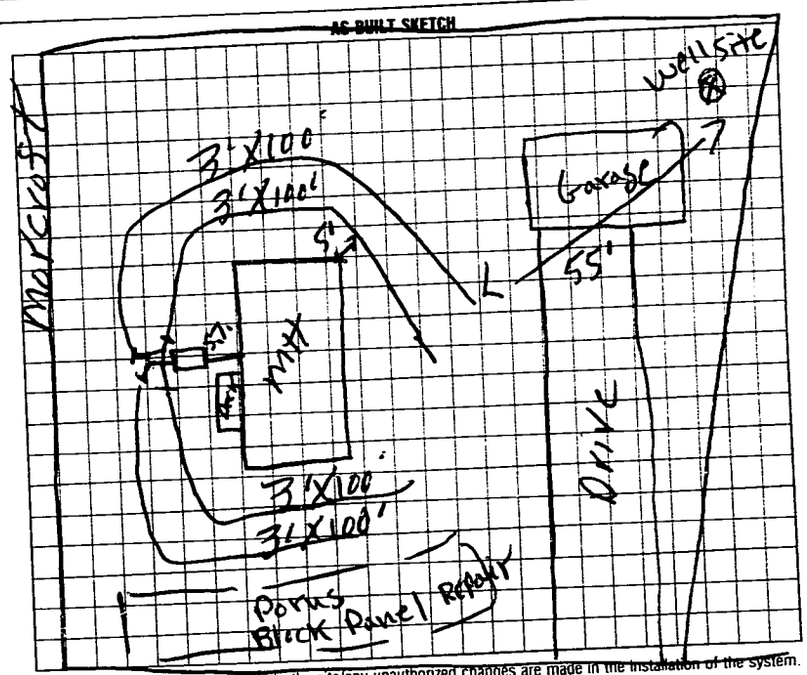

I understand that this permit can be suspended or revoked if any false information is supplied toward securing the permit any unauthorized changes are made to the site/any unauthorized changes are made in the installation of the system. Improvement Permit is valid for 60 months from date of issuance.

Signed: x Mike Cameron Agent For Owner date 10-5-93

Improvement Permit by: J.C. moore date

Existing System Inspection by: date

Installed by: Dellinger Grading Water Moss Dr.

Certificate of Completion by: J.C. moore date 10-20-93

Operation Permit by: date

HEALTH DEPT. COPY: WHITE INSPECTION COPY (FINAL): GREEN OWNER COPY (FINAL): YELLOW INSPECTION COPY (INITIAL): PINK OWNER COPY (INITIAL): GOLD

J