IREDELL COUNTY HEALTH DEPARTMENT

STATESVILLE 704-878-5305 MOORESVILLE 704-664-5281

IMPROVEMENT PERMIT / CERTIFICATE OF COMPLETION / OPERATION PERMIT / EXISTING SYSTEM INSPECTION

PROPERTY DESCRIPTION NO. 18072 DATE 3-30-94 TAX MAP NO. 5E-2-A-96 Watershed: ☐ Yes ☑ No

OWNER OR CONTRACTOR Clinton Easter PHONE: Business _____ Home _____

ADDRESS 6481 Enochville Road Kannapolis N.C.

LOCATION 70 E TR Triplett Rd TL water moss before Gone a way Farm

SUBDIVISION Willow Ridge BLOCK / SECTION II LOT 96 LOT AREA 1 acre + SITE CLASS PS DESIGN FLOW 240 L.T.A.R. .3gal/sq ft/day

Septic Tank: 1000 Gallons; STB 794 Date 12-17-93

Pump Tank: _____ Gallons; PT _____ Date _____

Pump Make: _____ Model _____ Serial No. _____

Nitrification Field: No Fields 1 Square Feet 810 Linear Feet 270

No Lines 3 Trench Width 36" Max Trench Bottom Depth 36" Gravel Depth 12"

☑ New System ☐ Repair System Type: I ☑ II, III, IV, V, VI

System Description: Conv. Gravity

Repair System Description: " "

Maintenance Agreement Required: ☐ Yes ☑ No

☐ House/Mod. Home No. Bedrooms 2

☑ Mobile Home No. Bathrooms 1

☐ Business No. Employees ____

☐ Other _____


☐ Slab ☑ Crawl Space ☐ Basement w/plumbing ☐ Basement wo/plumbing

Water Supply: ☑ Individual ☐ Community ☐ Public

Comments:

Comments: mobile Home not located at this inspection located at proper distance from S.T. System

INITIAL SITE SKETCH

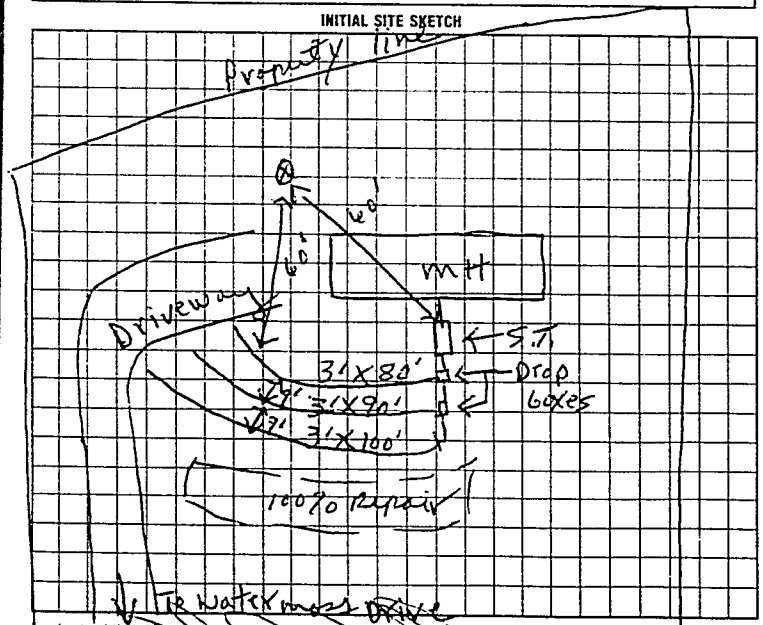

AS BUILT SKETCH

Same as initial Sketch

I understand that this permit can be suspended or revoked if any false information is supplied toward securing the permit/any unauthorized changes are made to the site/any unauthorized changes are made in the installation of the system. Improvement Permit is valid for 60 months from date of issuance.

Signed: X _____

Improvement Permit by: J. C. Moore date 3-30-94

Existing System Inspection by: _____ date _____

Installed by: Kenny Dellinger

Certificate of Completion by: J. C. Moore date 4-20-94

Operation Permit by: _____ date _____

HEALTH DEPT. COPY: WHITE INSPECTION COPY (FINAL): GREEN OWNER COPY (FINAL): YELLOW INSPECTION COPY (INITIAL): PINK OWNER COPY (INITIAL): GOLD