IREDELL COUNTY HEALTH DEPARTMENT

STATESVILLE 704-878-5305 MOORESVILLE 704-664-5281

IMPROVEMENT PERMIT / CERTIFICATE OF COMPLETION / OPERATION PERMIT / EXISTING SYSTEM INSPECTION

PROPERTY DESCRIPTION NO. 25640 DATE 12-4-96 TAX MAP NO. 5F-2-A-96 Watershed: ☐ Yes ☒ No

OWNER OR CONTRACTOR PBS Realty PHONE: Business 704-532-6527 Home

ADDRESS 5551 Monroe Rd Charlotte, N.C.

LOCATION 70E TR Tripiett Rt TL water miss 2nd Drive on Rt ~~Sement~~ Part Winding Arbor

SUBDIVISION Willow Ridge BLOCK / SECTION II LOT 96 LOT AREA 1 acre SITE CLASS. DESIGN FLOW 360 L.T.A.R. .3

Septic Tank: EX 1000 Gallons; STB 794 Date 12-17-93 ☐ New System ☒ Repair System Type: I, II, III, IV, V, VI

Pump Tank: Gallons; PT Date System Description:

Pump Make: Model Serial No. Repair System Description: Adding c.o.w. line

Nitrification Field: No Fields 1 Square Feet 376 Linear Feet 130 Maintenance Agreement Required: ☐ Yes ☐ No

No Lines 1 Trench Width 36" Max Trench Bottom Depth 36" Gravel Depth 12"

☐ House/Mod. Home ☒ Mobile Home ☐ Business ☐ Other

No. Bedrooms 3 No. Bathrooms 2 No. Employees

☐ Slab ☒ Crawl Space ☐ Basement w/plumbing ☐ Basement wo/plumbing


Water Supply: ☒ Individual ☐ Community ☐ Public

Comments:

Adding Drain line to bring up to 3 bedroom System from a 2 bedroom EX. System

Comments:

INITIAL SITE SKETCH

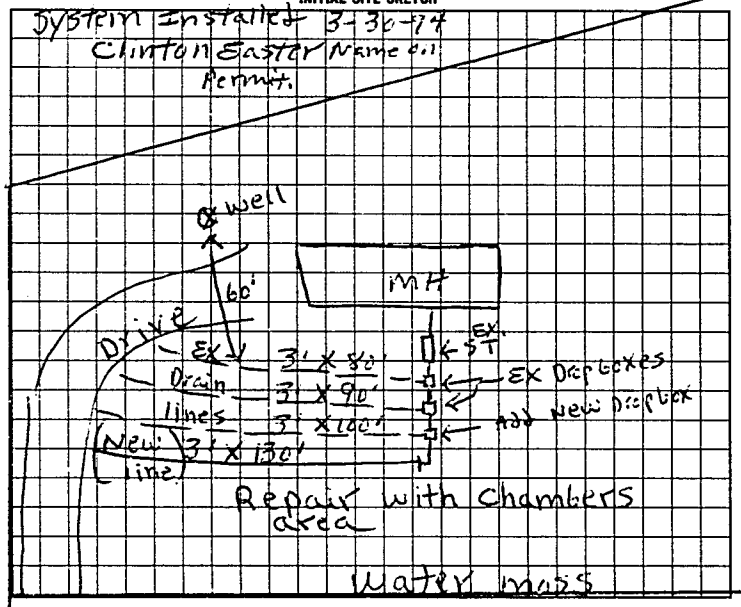

AS BUILT SKETCH

SYSTEM UPGRADED ACCORDING TO INITIAL SITE SKETCH.

I understand that this permit can be suspended or revoked if any false information is supplied toward securing the permit/any unauthorized changes are made to the site/any unauthorized changes are made in the installation of the system. Improvement Permit is valid for 60 months from date of issuance.

Signed: [signature]

Improvement Permit by: L. C. Moore date 12-4-96

Existing System Inspection by: L. C. Moore date 12-4-96

Installed by: DELLINGER GRADING

Certificate of Completion by: date

Operation Permit by STEVE HERRICK date 12-30-96

TO CO. HEALTH DEPT. COPY: WHITE INSPECTION COPY (FINAL): GREEN OWNER COPY (FINAL): YELLOW INSPECTION COPY (INITIAL): PINK OWNER COPY (INITIAL): GOLD

Authorization to Const Expires 60 mos from issue

8 2 7 1 0 0