12:00

60692

IREDELL COUNTY HEALTH DEPARTMENT

STATESVILLE 704-878-5305 MOORESVILLE 704-664-5281

IMPROVEMENT PERMIT / CERTIFICATE OF COMPLETION / OPERATION PERMIT / EXISTING SYSTEM INSPECTION

PROPERTY DESCRIPTION NO. 23328 DATE 4-9-96 TAX MAP NO. 5E-2-A-75 Watershed: ☐ Yes ☒ No

OWNER OR CONTRACTOR David Unger PHONE: Business Home 528-6559

ADDRESS PO Box 5000-256 Mooresville, N.C. 28115

LOCATION 70E TR Triplett TL water moss on Rt at left

SUBDIVISION Willow Ridge BLOCK / SECTION LOT 75 LOT AREA .86acres SITE CLASS PS DESIGN FLOW 360 L.T.A.R. 13

Septic Tank: 1000 Gallons; STB 921 Date 5-22-96

Pump Tank: Gallons; PT Date

Pump Make: Model Serial No.

Nitrification Field: No Fields 1 Square Feet 1200 Linear Feet 400

No Lines 4 Trench Width 36" Max Trench Bottom Depth 36" Gravel Depth 12"

☒ New System ☐ Repair System Type: I (II) III. IV. V. VI

System Description: Conv. Gravity

Repair System Description: Gravity Chambers

Maintenance Agreement Required: ☐ Yes ☒ No

☐ House/Mod. Home No. Bedrooms 3

☒ Mobile Home No. Bathrooms 2


☐ Business No. Employees

☐ Other

☐ Slab ☒ Crawl Space ☐ Basement w/plumbing ☐ Basement wo/plumbing


Water Supply: ☒ Individual ☐ Community ☐ Public

Comments:

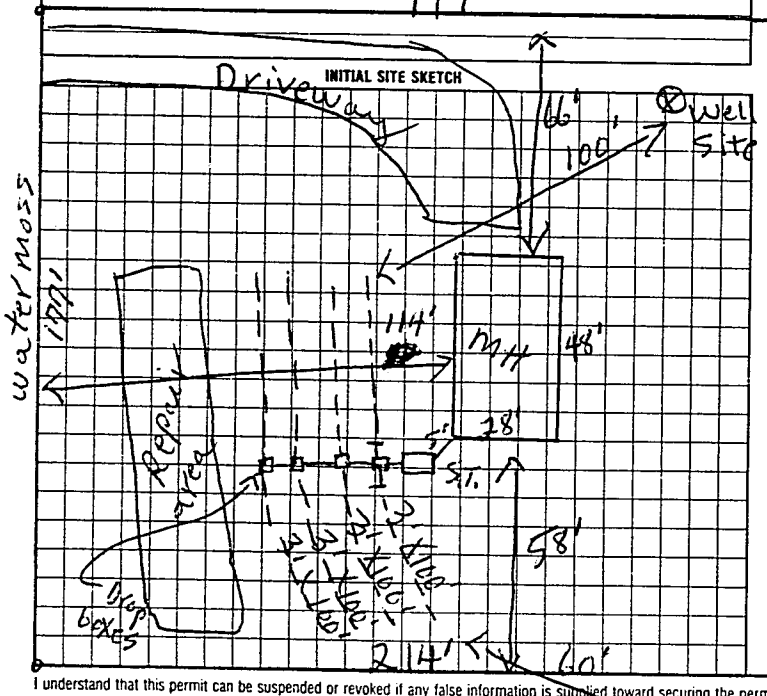

Comments: well + mobile Home Not on site at Time of This inspection

AS BUILT SKETCH

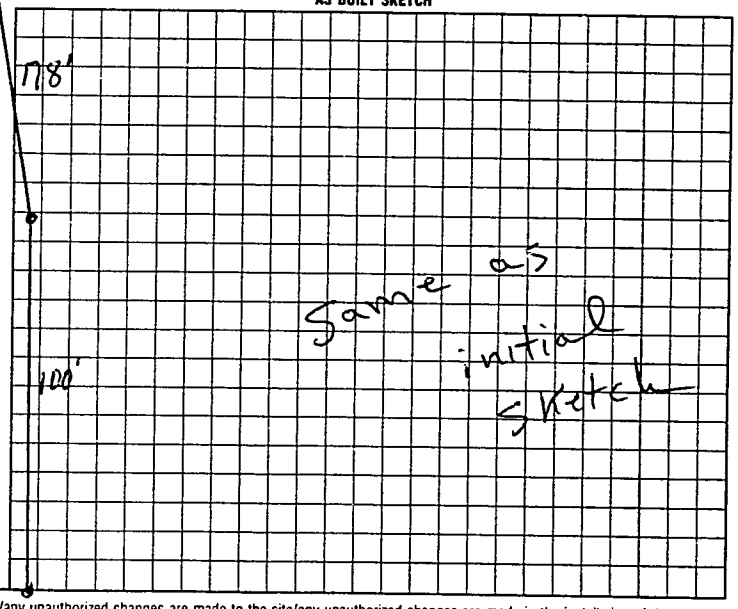

I understand that this permit can be suspended or revoked if any false information is supplied toward securing the permit/any unauthorized changes are made to the site/any unauthorized changes are made in the installation of the system.

Signed: X Dawn G. Gariada

Improvement Permit by: J.C. Moore date 4-9-96

~~Existing System Inspection~~ Authorized Entity by: J.C. Moore date 4-9-96

Installed by: G&M Enterprises

Certificate of Completion by: date

Operation Permit by: J.C. Moore date 6-20-96

HEALTH DEPT. COPY: WHITE INS. ECTION COPY (FINAL): GREEN OWNER COPY (FINAL): YELLOW INSPECTION COPY (INITIAL): PINK OWNER COPY (INITIAL): GOLD

Authorization to count EXPIRES 60 mos From issue

8 E 9 2 0 0