IREDELL COUNTY HEALTH DEPARTMENT

STATESVILLE 704-878-5305 MOORESVILLE 704-664-5281

IMPROVEMENT PERMIT / CERTIFICATE OF COMPLETION / OPERATION PERMIT / EXISTING SYSTEM INSPECTION

PROPERTY DESCRIPTION NO. 17359 DATE 11-1-93 TAX MAP NO. 5F-2-A-89 Watershed: ☐ Yes ☑ No

OWNER OR CONTRACTOR Janita H. Tutterow PHONE: Business Home 664-3706

ADDRESS PO BOX 1032 Mooresville

LOCATION 70E TR Triplett TL water moss TR Gone-a-way 1/8 mi on left

SUBDIVISION Willow Ridge BLOCK / SECTION 2 LOT 89 LOT AREA 1.07 acres SITE CLASS. PS DESIGN FLOW 240 L.T.A.R. .35

Septic Tank: 1000 Gallons; STB 794 Date 8-8-93

Pump Tank: Gallons; PT Date

Pump Make: Model Serial No.

Nitrification Field: No Fields 1 Square Feet 720 Linear Feet 240

No Lines 2 Trench Width 36 Max Trench Bottom Depth 36

☐ New System ☐ Repair System Type: I (II) III, IV, V, VI

System Description: Conv. Gravity

Repair System Description:

Maintenance Agreement Required: ☐ Yes ☑ No

Gravel Depth 12

☐ House/Mod. Home No. Bedrooms 3

☑ Mobile Home No. Bathrooms 2

☐ Business No. Employees

☐ Other


☐ Slab ☐ Crawl Space ☐ Basement w/plumbing ☐ Basement wo/plumbing

Water Supply: ☑ Individual ☐ Community ☐ Public


Comments:

Comments: well & mobile Home were not on site at Time of inspection locate them proper distances from S.T. systems

INITIAL SITE SKETCH

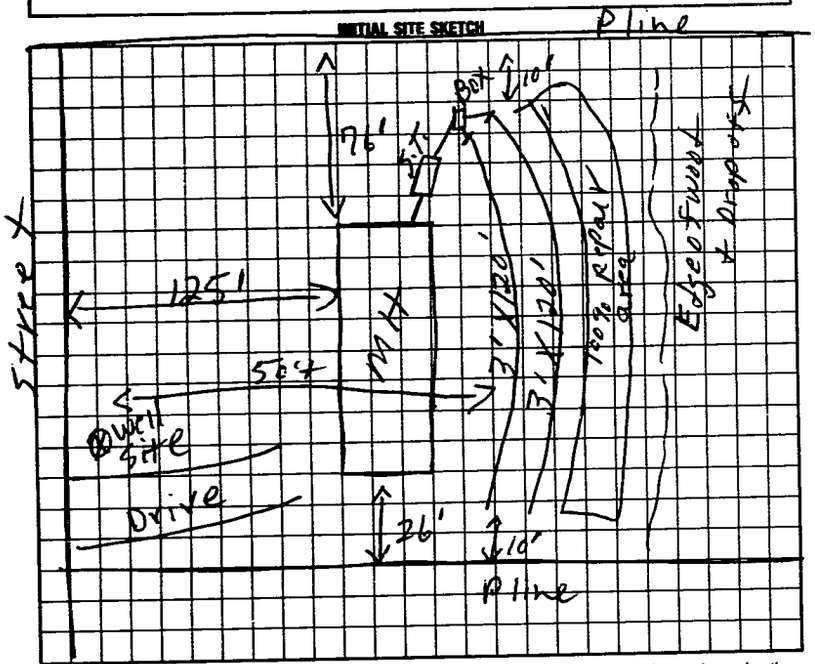

AS BUILT SKETCH

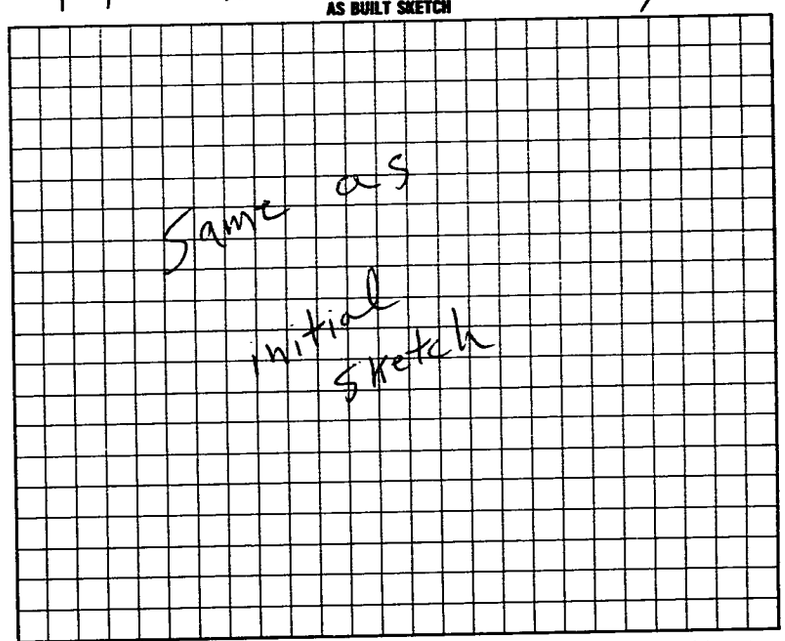

I understand that this permit can be suspended or revoked if any false information is supplied toward securing the permit/any unauthorized changes are made to the site/any unauthorized changes are made in the installation of the system. Improvement Permit is valid for 60 months from date of issuance.

Signed: X Billy w Peyton Agent

Improvement Permit by: P.C. Moore date 11-1-93

Existing System Inspection by: date

Installed by: Dellinger S.T.

Certificate of Completion by: P.C. moore date 11-9-93

Operation Permit by: date

HEALTH DEPT. COPY: WHITE INSPECTION COPY (FINAL): GREEN OWNER COPY (FINAL): YELLOW INSPECTION COPY (INITIAL): PINK OWNER COPY (INITIAL): GOLD