IREDELL COUNTY HEALTH DEPARTMENT

STATESVILLE 704-878-5305 MOORESVILLE 704-664-5281

IMPROVEMENT PERMIT / CERTIFICATE OF COMPLETION / OPERATION PERMIT / EXISTING SYSTEM INSPECTION

PROPERTY DESCRIPTION NO. 18753 DATE 7-21-94 TAX MAP NO. 5F-2-A-88 Watershed: ☐ Yes ☑ No

OWNER OR CONTRACTOR Harold Gulledge PHONE: Business _____ Home 663 0127

ADDRESS 140 E Wilson Mooresville

LOCATION 70 E TR Triplett Rd To Watermoss TR Gateaway 2nd lot on left

SUBDIVISION Willow Ridge BLOCK / SECTION II LOT 88 LOT AREA 1.16 acres SITE CLASS. PS DESIGN FLOW 360 L.T.A.R. 3

Septic Tank: 1000 Gallons; STB 1194 Date 7-6-94

Pump Tank: _____ Gallons; PT _____ Date _____

Pump Make: _____ Model _____ Serial No. _____

Nitrification Field: No Fields ____ Square Feet _____ Linear Feet _____

No Lines _____ Trench Width _____ Max Trench Bottom Depth _____ Gravel Depth _____

☑ New System ☐ Repair System Type: I, II, III, IV, V, VI

System Description: Conv. Gravity

Repair System Description: Gravity Torus Block Pipe

Maintenance Agreement Required: ☐ Yes ☑ No

☐ House/Mod. Home No. Bedrooms 3

☑ Mobile Home No. Bathrooms 2

☐ Business No. Employees ____

☐ Other _____


☐ Slab ☑ Crawl Space ☐ Basement w/plumbing ☐ Basement wo/plumbing

Water Supply: ☑ Individual ☐ Community ☐ Public

Comments:

Comments: well + mobile Not located at Time of This Inspection. Keep Them proper distances from S.T. System

INITIAL SITE SKETCH 256'

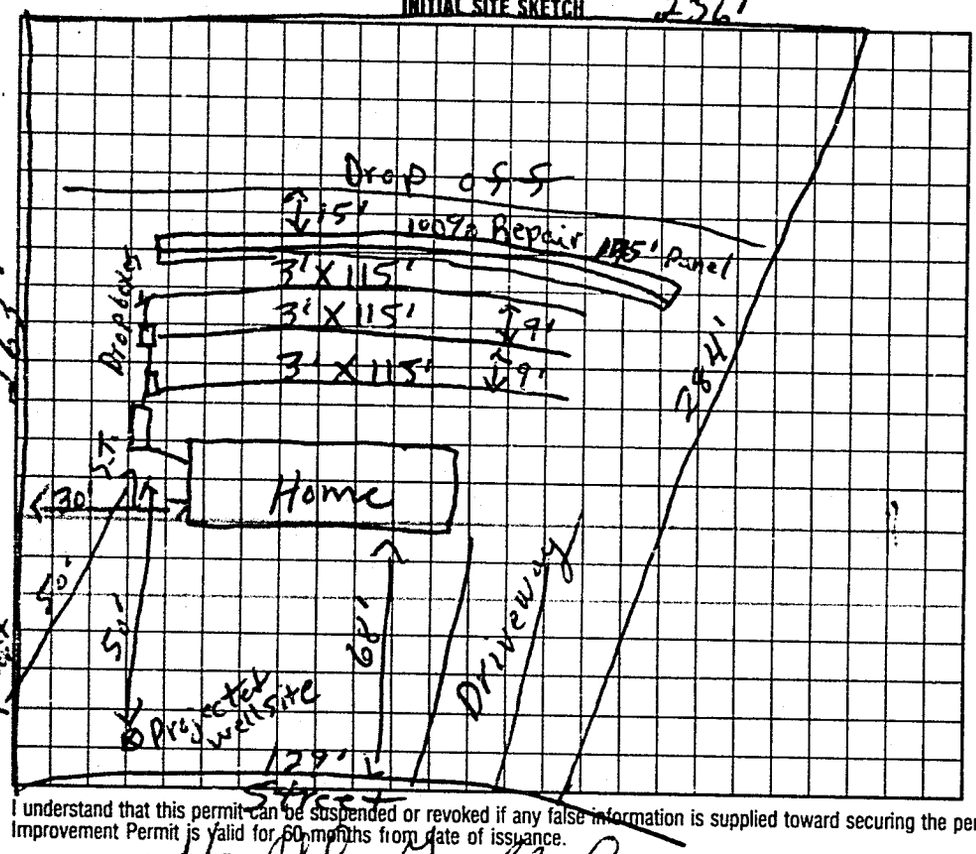

AS BUILT SKETCH

Same as initial sketch

I understand that this permit can be suspended or revoked if any false information is supplied toward securing the permit/any unauthorized changes are made to the site/any unauthorized changes are made in the installation of the system. Improvement Permit is valid for 60 months from date of issuance.

Signed: x Harold Gulledge

Improvement Permit by: J.C. Moore date 7-21-94

Existing System Inspection by: _____ date _____

Installed by: Kenny Dellinger

Certificate of Completion by: J.C. Moore date 8-26-94

Operation Permit by: _____ date _____

HEALTH DEPT. COPY: WHITE INSPECTION COPY (FINAL): GREEN OWNER COPY (FINAL): YELLOW INSPECTION COPY (INITIAL): PINK OWNER COPY (INITIAL): GOLD