1:00

IREDELL COUNTY HEALTH DEPARTMENT - *ENVIRONMENTAL HEALTH* ☐ STATESVILLE OFFICE 704-878-5305 ☐ MOORESVILLE OFFICE 704-664-5281

IMPROVEMENT PERMIT / AUTHORIZATION TO CONSTRUCT / OPERATION PERMIT / EXISTING SYSTEM INSPECTION

PERMIT # 171164 PIN # 4771-46-7632 DATE MARCH 9, 2012

OWNER JESSICA & EDMUND RITCHIE APPLICANT: SAME PHONE: Home/Cell # Business #

SITE ADDRESS 126 GONEAWAY LANE, CLEVELAND OWNER / APPLICANT ADDRESS 126 GONEAWAY LANE, CLEVELAND, NC 27013

SITE DIRECTIONS TRIPLETT ROAD, TL WATERMOSS ROAD, TR GONEAWAY LANE, 1ST DRIVEWAY ON LEFT

SUBDIVISION WILLOW RIDGE BLOCK / SECTION 2 LOT # 87 LOT AREA 1.54 ACRES DESIGN FLOW 360 L.T.A.R. 0.25 GPD/FT2

Septic Tank EXISTING Gallons: STB Date

Pump Tank Gallons: P T Date

Pump Make Model Serial #

No. Nitrification Fields: 1 No. Lines 3 Linear Feet 120+

Trench Width 36" Max. Trench Bottom Depth 30"

~~Initial System~~ ☐ Repair ☑ Expansion System Type I II ☑ III IV V VI

System Description: 25% REDUCTION, GRAVITY

Repair System Description: 50% REDUCTION, LOW-PRESS

Maintenance Agreement Required ☐ YES ☑ NO

Gravel Depth N/A ☑ GRAVITY ☐ PRESSURE

☑ Residence No. Bedrooms 3

☐ Business No. Persons

☐ Other No. Employees


☐ Slab ☑ Crawl Space

☐ Basement w/plumbing ☐ Basement w/o plumbing

Water Supply: ☑ Private WELL ☐ Public ☐ Community

Comments / Conditions: ① INSTALL NEW 25% REDUCTION DRAINLINES USING SERIAL DISTRIBUTION. ② SET NEW DROP BOX AT LOCATION SHOWN IN LOWER EXISTING DRAINLINE FEEDING NEW SYSTEM ③ KEEP SYSTEM MIN. 15' FROM EMBANKMENT

INITIAL SITE SKETCH

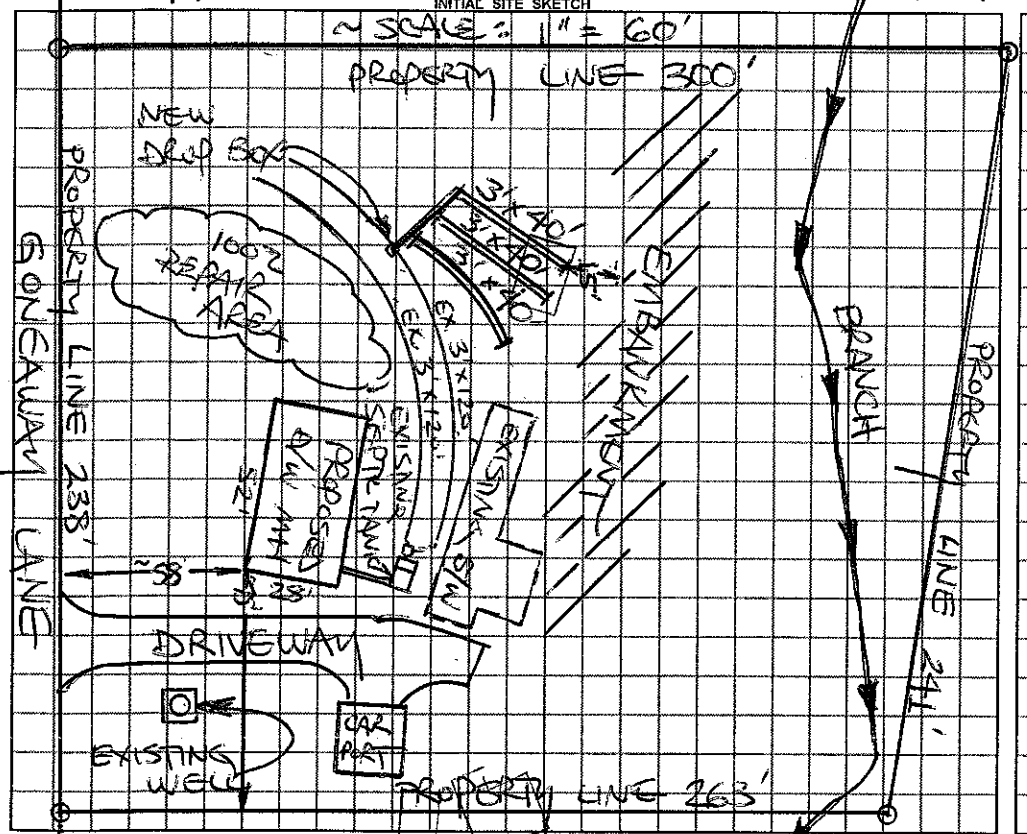

AS BUILT SKETCH

Permit can be suspended or revoked if any false information is supplied toward securing the permit / any unauthorized changes are made to the site / any unauthorized changes are made in the installation of the system.

☐ ***IMPROVEMENT PERMIT*** *with plat valid without expiration.* ☑ ***IMPROVEMENT PERMIT*** *with plat valid without expiration.* *site plan valid 90 mo.* ☑ ***AUTHORIZATION TO CONSTRUCT*** valid for period equal to IMPROVEMENT PERMIT--not to exceed 60 mo.

Owner / Applicant Signature: Jessica Ritchie Date 3/12/12 Installed by: Kevin Bowles

IMPROVEMENT PERMIT by: R. STEVE HEDRICK REHS Date 3/9/2012 OPERATION PERMIT by: REHS Date 3-19-12

AUTHORIZATION TO CONSTRUCT by: R. STEVE HEDRICK REHS Date 3/9/2012 Existing System Inspected by: REHS Date

YOU SHOULD CONTACT A LOCATOR SERVICE PRIOR TO ANY EXCAVATION

White Copy – Environmental Health YELLOW COPY (Final) Owner / Applicant PINK COPY (Initial) Owner / Applicant