IREDELL COUNTY HEALTH DEPARTMENT

Statesville Office (704) 878-5305 Mooresville Office (704) 660-3625 PERMIT # 212239

IMPROVEMENT PERMIT / AUTHORIZATION TO CONSTRUCT / OPERATION PERMIT / EXISTING SYSTEM

PIN # 4771467834

APPLICANT: Eric Ward APPLICANT ADDRESS: 127 Abington Ln.

SITE ADDRESS: 138 Goneaway Ln. PHONE: 704-883-6148 ALT. PHONE: N/A

SITE DIRECTIONS: Hwy 70 E TR Triplett Rd TL Watermass TL Goneaway Property on Right

SUBDIVISION: Willow Ridge SECTION: P2M2 LOT # 86 LOT AREA: 1.77acres DESIGN FLOW: 360gpd L.T.A.R.: 0.25

Septic Tank Existing (gal) STB Date

Pump Tank (gal) PT Date

Pump Make Model Serial #

Nitrification Fields 1 # Lines 4 Linear Ft: 140

Trench Width 36" Max. Trench Bottom Depth 36" Gravel Depth 12"

☐ New System ☐ Repair ☑ Expansion System Type: I II (III) IV V VI

System Description: Conventional + 25% Red.

Repair System Description: 50% Reduction

Maintenance Agreement Required: ☐ YES ☑ NO

☐ GRAVITY ☐ PRESSURE

☑ Residence ☐ Business ☐ Other ☐ Slab ☐ Basement w/plumbing


No. Bedrooms 3 No. Persons 6 No. Employees ☑ Crawl Space

Water Supply: ☑ Private ☐ Public ☐ Community


☐ Basement w/o plumbing

Comments / Conditions: Extend existing gravel lines by 20' each. Set a new drop box at Lowest existing line as shown below. Install an 80' 25% Reduction line + connect to existing drainfield as shown below.

INITIAL SITE SKETCH

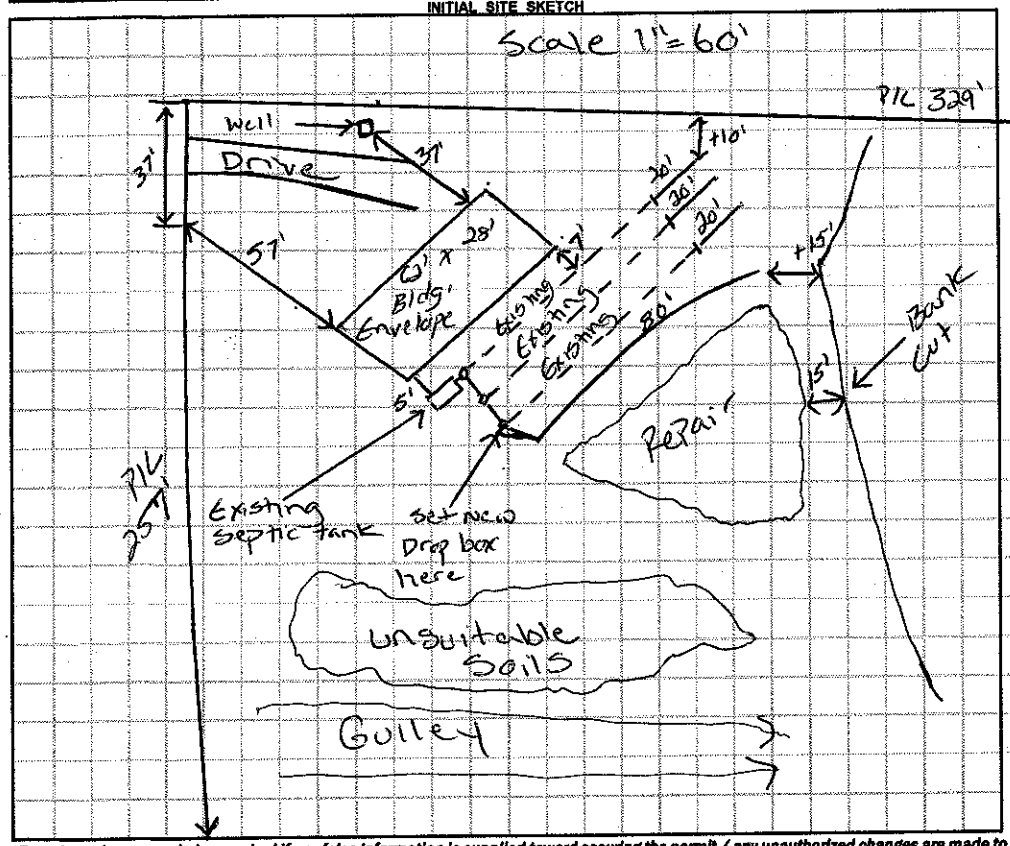

AS BUILT SKETCH

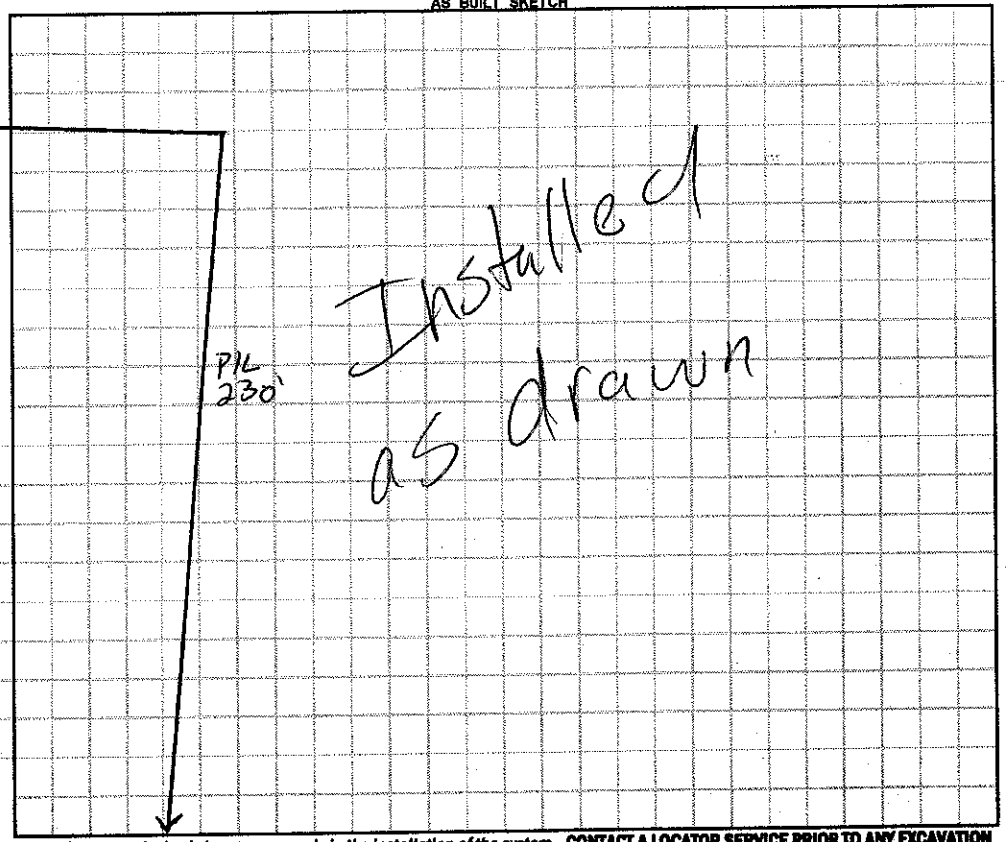

Permit can be suspended or revoked if any false information is supplied toward securing the permit / any unauthorized changes are made to the site / any unauthorized changes are made in the installation of the system. **CONTACT A LOCATOR SERVICE PRIOR TO ANY EXCAVATION**

☐ **IMPROVEMENT PERMIT** *with plat valid without expiration.* ☑ **IMPROVEMENT PERMIT** *with site plan valid for 60 mos.* ☑ **AUTHORIZATION TO CONSTRUCT** *valid for period equal to IMPROVEMENT PERMIT--not to exceed 60 mo.*

Owner / Applicant Signature: Eric Ward Date: 8-21-15 Installed by: Tommy Fry

IMPROVEMENT PERMIT by: Justin Henderson Date: 8-21-15 OPERATION PERMIT by: Justin Henderson Date: 09/14/15

AUTHORIZATION TO CONSTRUCT by: Justin Henderson Date: 8-21-15 Existing System Inspected by: Date:

Health Dept. Copy - WHITE Applicant (Final Approval) - YELLOW Applicant (Conditional Approval) - PINK