IREDELL COUNTY HEALTH DEPARTMENT

STATESVILLE 704-878-5305 MOORESVILLE 704-664-5281

IMPROVEMENT PERMIT / CERTIFICATE OF COMPLETION / OPERATION PERMIT / EXISTING SYSTEM INSPECTION

PROPERTY DESCRIPTION NO. 17635 DATE 1-14-94 TAX MAP NO. 5F-2-A-86 Watershed: ☐ Yes ☒ No

OWNER OR CONTRACTOR Teresa Beaudoin PHONE: Business Home 664-4465

ADDRESS Rt 7 Box 223 Mooresville, N.C.

LOCATION 70E TR Triplett Rd TL water mess To end TL Gone Away 3rd lot rt.

SUBDIVISION Willow Ridge BLOCK / SECTION LOT 86 LOT AREA 1/2acre + SITE CLASS. PS DESIGN FLOW 240 L.T.A.R. .35

Septic Tank: 1000 Gallons; STB 794 Date 1-4-94

Pump Tank: Gallons; PT Date

Pump Make: Model Serial No.

Nitrification Field: No Fields 1 Square Feet 720 Linear Feet 240

No Lines 3 Trench Width 36 Max Trench Bottom Depth [redacted].24 Gravel Depth 12

☒ New System ☐ Repair System Type: I (II) III, IV, V, VI

System Description: Conv. Gravity

Repair System Description:

Maintenance Agreement Required: ☐ Yes ☐ No

☐ House/Mod. Home ☒ Mobile Home ☐ Business ☐ Other

No. Bedrooms 2 No. Bathrooms 2 No. Employees


☐ Slab ☒ Crawl Space ☐ Basement w/plumbing ☐ Basement wo/plumbing

Water Supply: ☒ Individual ☐ Community ☐ Public


Comments:

Comments: mH + well not located at Time of this inspection Keep proper distances from S.T. System

INITIAL SITE SKETCH

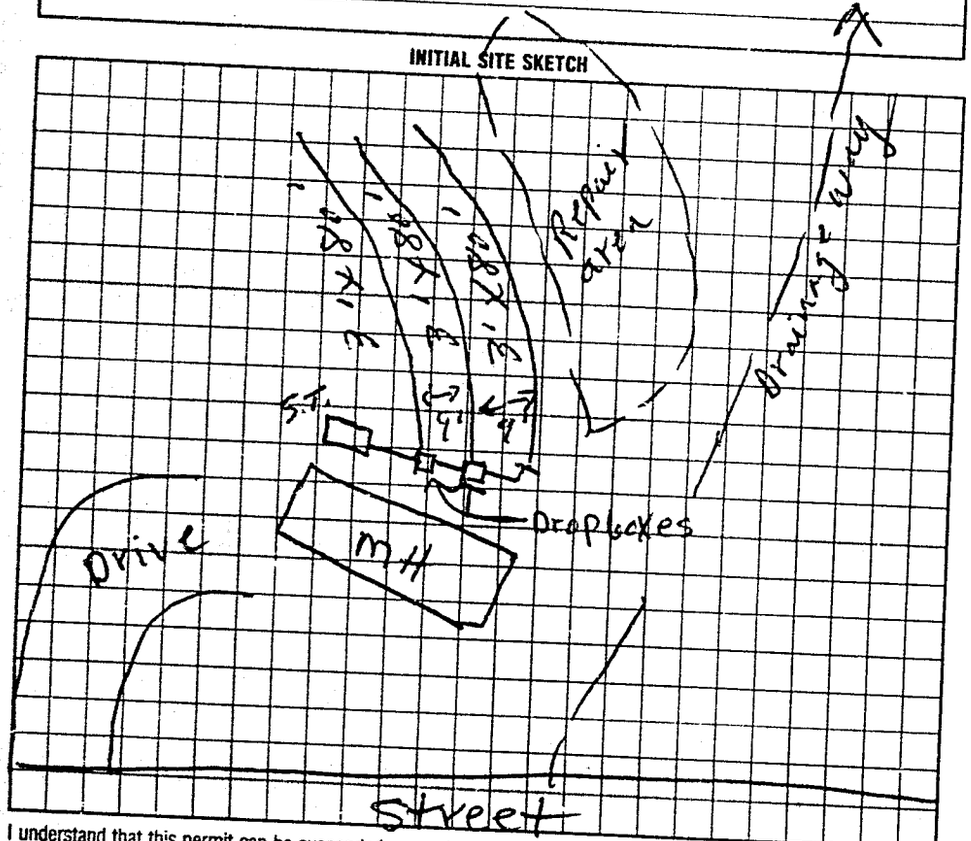

AS BUILT SKETCH

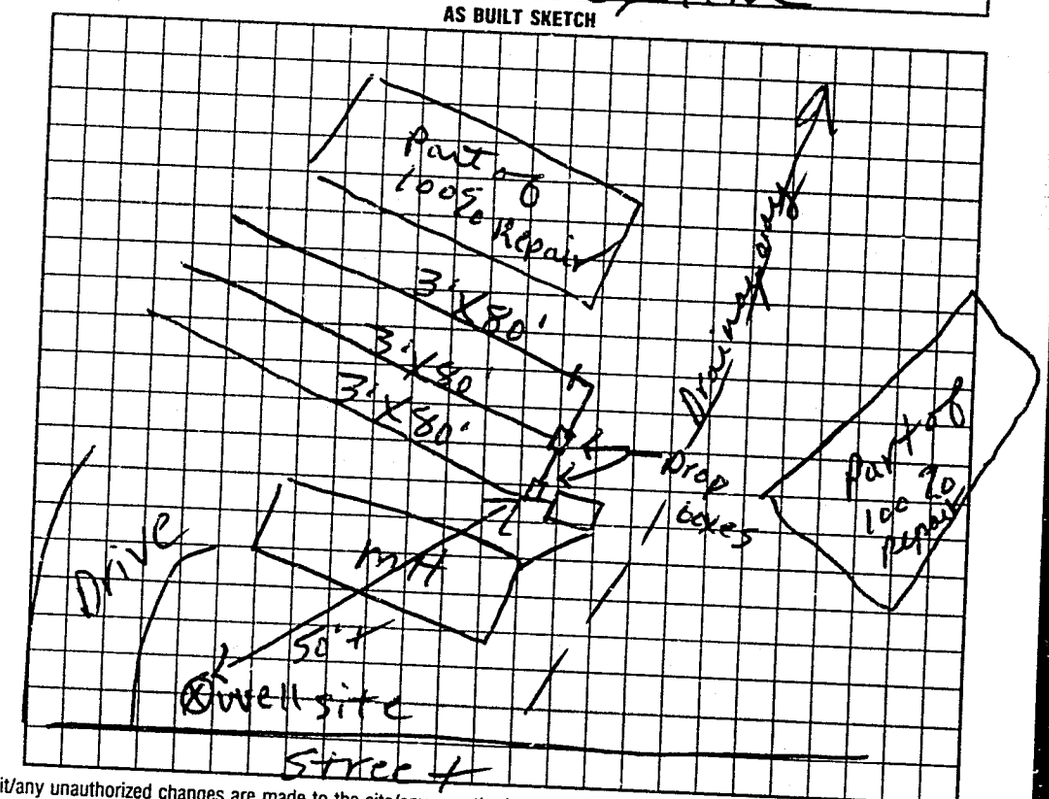

I understand that this permit can be suspended or revoked if any false information is supplied toward securing the permit/any unauthorized changes are made to the site/any unauthorized changes are made in the installation of the system. Improvement Permit is valid for 60 months from date of issuance.

Signed:

Improvement Permit by: J. C. Moore date 1-14-94

Existing System Inspection by: date

Installed by: Kenny Rollings

Certificate of Completion by: J. C. Moore date 2-9-94

Operation Permit by: date

HEALTH DEPT. COPY: WHITE INSPECTION COPY (FINAL): GREEN OWNER COPY (FINAL): YELLOW INSPECTION COPY (INITIAL): PINK OWNER COPY (INITIAL): GOLD