Issued on computer

IREDELL COUNTY HEALTH DEPARTMENT

STATESVILLE 704-878-5305 MOORESVILLE 704-664-5281

IMPROVEMENT PERMIT / CERTIFICATE OF COMPLETION / OPERATION PERMIT / EXISTING SYSTEM INSPECTION

PROPERTY DESCRIPTION NO. 18570 DATE 5-26-94 TAX MAP NO. 5F-2 Watershed: ☐ Yes ☑ No

OWNER OR CONTRACTOR James A. Carr PHONE: Business _____ Home 664-7738

ADDRESS 442 West Mellenland Mooresville

LOCATION 70 E TR Triplett Rd TL Watermoss Dr. TL Marcroft Ln 3rd lot Rt

SUBDIVISION Willow Ridge BLOCK / SECTION _____ LOT 72 LOT AREA 140'X253' SITE CLASS. PS DESIGN FLOW 360 L.T.A.R. .35

Septic Tank: 1000 Gallons; STB 794 Date 5-4-94

Pump Tank: _____ Gallons; PT _____ Date _____

Pump Make: _____ Model _____ Serial No. _____

Nitrification Field: No Fields 1 Square Feet 1050 Linear Feet 350

No Lines 3 Trench Width 36" Max Trench Bottom Depth 36" Gravel Depth 12"

☑ New System ☐ Repair System Type: I, II, III, IV, V, VI

System Description: Conv. Gravity

Repair System Description: " "

Maintenance Agreement Required: ☐ Yes ☑ No

☐ House/Mod. Home ☑ Mobile Home ☐ Business ☐ Other

No. Bedrooms 3 No. Bathrooms 2 No. Employees ____


☐ Slab ☑ Crawl Space ☐ Basement w/plumbing ☐ Basement wo/plumbing

Water Supply: ☑ Individual ☐ Community ☐ Public

Comments:

Comments: Home not located at time of inspection, Keep home 5' min from any part of septic Tank.

INITIAL SITE SKETCH

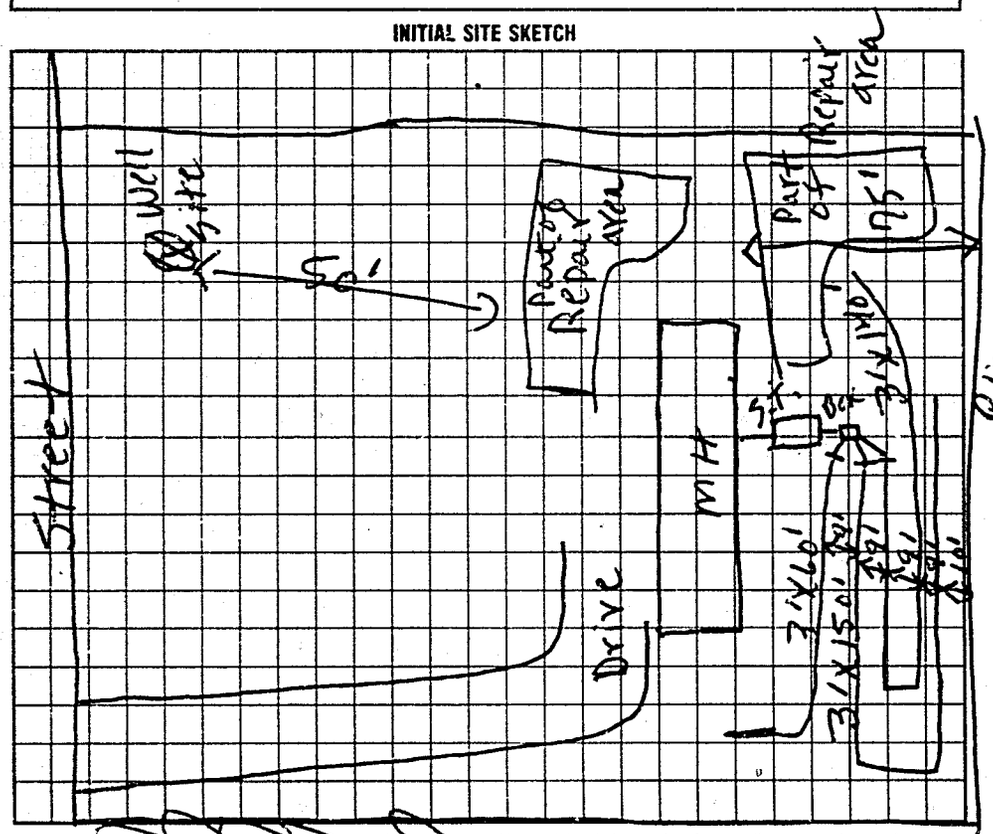

AS BUILT SKETCH

SAME AS INITIAL SKETCH

I understand that this permit can be suspended or revoked if any false information is supplied toward securing the permit/any unauthorized changes are made to the site/any unauthorized changes are made in the installation of the system. Improvement Permit is valid for 60 months from date of issuance.

Signed: X _____

Improvement Permit by: P.C. Moore date 5-26-94

Existing System Inspection by: _____ date _____

Installed by: Dellinger Grading

Certificate of Completion by: Michael J. Dennis date 6-15-94

Operation Permit by: _____ date _____

HEALTH DEPT. COPY: WHITE INSPECTION COPY (FINAL): GREEN OWNER COPY (FINAL): YELLOW INSPECTION COPY (INITIAL): PINK OWNER COPY (INITIAL): GOLD