IREDELL COUNTY HEALTH DEPARTMENT

STATESVILLE 704-878-5305 MOORESVILLE 704-664-5281

IMPROVEMENT PERMIT / CERTIFICATE OF COMPLETION / OPERATION PERMIT / EXISTING SYSTEM INSPECTION

PROPERTY DESCRIPTION NO. 17389 DATE 11-[illegible]93 TAX MAP NO. 5F-2-A-11 Watershed: ☐ Yes ☐ No

OWNER OR CONTRACTOR Brenda Lee Rucker PHONE: Business 5 Home 664-2774

ADDRESS 336 Cabarrus Ave Mooresville

LOCATION 70 E TO Triplett TL waterman TL Morcroft 1/8 mi on Rt

SUBDIVISION Wilbar Ridge BLOCK / SECTION II LOT 71 LOT AREA 140X252 SITE CLASS PS DESIGN FLOW 240 L.T.A.R. .35

Septic Tank: 1000 Gallons; STB 825 Date 9-5-93

Pump Tank: _____ Gallons; PT _____ Date _____

Pump Make: _____ Model _____ Serial No. _____

Nitrification Field: No Fields 1 Square Feet 720 Linear Feet 240

No Lines 2 Trench Width 36" Max Trench Bottom Depth 36" Gravel Depth 12"

☑ New System ☐ Repair System Type: I, II, III, IV, V, VI

System Description: conv. Gravity

Repair System Description: " "

Maintenance Agreement Required: ☐ Yes ☐ No

☐ House/Mod. Home ☑ Mobile Home ☐ Business ☐ Other

No. Bedrooms 2 No. Bathrooms 2 No. Employees ____


☐ Slab ☑ Crawl Space ☐ Basement w/plumbing ☐ Basement wo/plumbing

Water Supply: ☑ Individual ☐ Community ☐ Public


Comments:

Comments: Home not located at time of this inspection located at proper distances from S.T. also landscape so that surface water will not stand over system

INITIAL SITE SKETCH

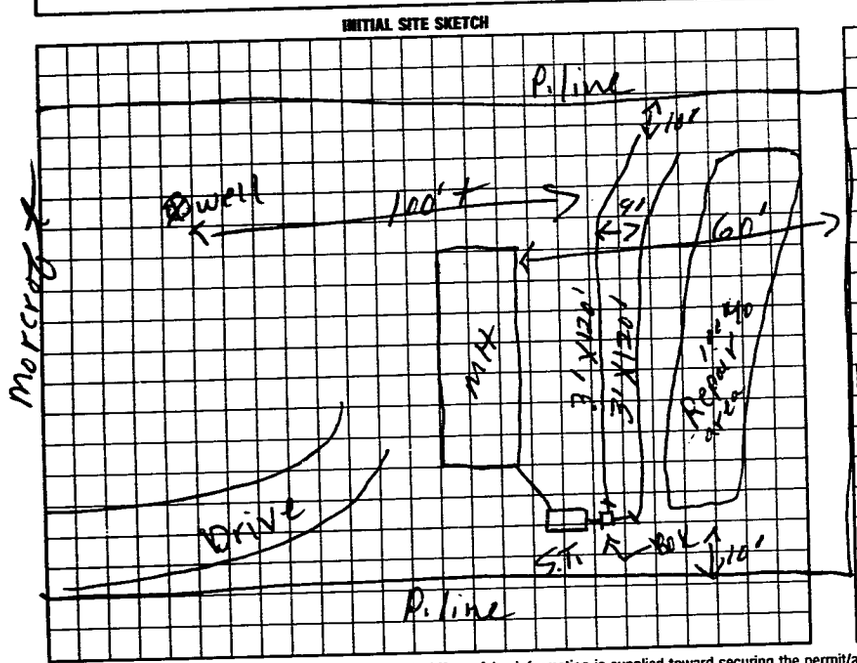

AS BUILT SKETCH

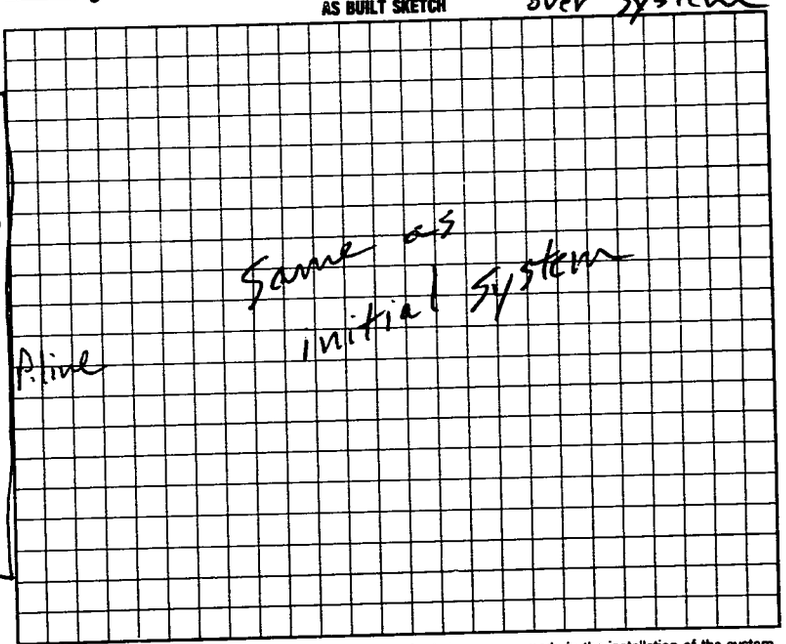

I understand that this permit can be suspended or revoked if any false information is supplied toward securing the permit/any unauthorized changes are made to the site/any unauthorized changes are made in the installation of the system. Improvement Permit is valid for 60 months from date of issuance.

Signed: Robert Steele for Brenda Lee Rucker

Improvement Permit by: F. C. moore date 11-5-93

Existing System Inspection by: _____ date _____

Installed by: Wayne Potts

Certificate of Completion by: F. C. moore date 12-2-93

Operation Permit by: _____ date _____

HEALTH DEPT. COPY: WHITE INSPECTION COPY (FINAL): GREEN OWNER COPY (FINAL): YELLOW INSPECTION COPY (INITIAL): PINK OWNER COPY (INITIAL): GOLD