IREDELL COUNTY HEALTH DEPARTMENT 17450

STATESVILLE 704-878-5305 MOORESVILLE 704-664-5281

IMPROVEMENT PERMIT / CERTIFICATE OF COMPLETION / OPERATION PERMIT / EXISTING SYSTEM INSPECTION

PROPERTY DESCRIPTION NO. 5E-2-A-69 DATE 11-17-93 TAX MAP NO. 5E-2-A-69 Watershed: ☐ Yes ☒ No

OWNER OR CONTRACTOR William Ivey PHONE: Business _____ Home _____

ADDRESS 169 morcroft Ln ~~Street~~ Cleveland

LOCATION 70E TR Triplett TL water moss TL morcroft before entering

SUBDIVISION willow ridge BLOCK / SECTION II LOT 69 LOT AREA 1.85 acres SITE CLASS. PS DESIGN FLOW 360 L.T.A.R. 1.35

Septic Tank: 1000 Gallons; STB 794 Date ~~9-24-93~~

Pump Tank: _____ Gallons; PT _____ Date 10-1-93

Pump Make: _____ Model _____ Serial No. _____

Nitrification Field: No Fields 1 Square Feet 1035 Linear Feet 345

No Lines 3 Trench Width 36" Max Trench Bottom Depth 36" Gravel Depth 12"

☒ New System ☐ Repair System Type: I, II, III, IV, V, VI

System Description: Conv. Gravity " "

Repair System Description: _____

Maintenance Agreement Required: ☐ Yes ☒ No

☐ House/Mod. Home No. Bedrooms 3

☒ Mobile Home No. Bathrooms 2

☐ Business No. Employees _____

☐ Other _____


☐ Slab ☒ Crawl Space ☐ Basement w/plumbing ☐ Basement wo/plumbing

Water Supply: ☒ Individual ☐ Community ☐ Public


Comments:

Comments: well not located at time of this inspection locate proper distance from S.T. systems

INITIAL SITE SKETCH

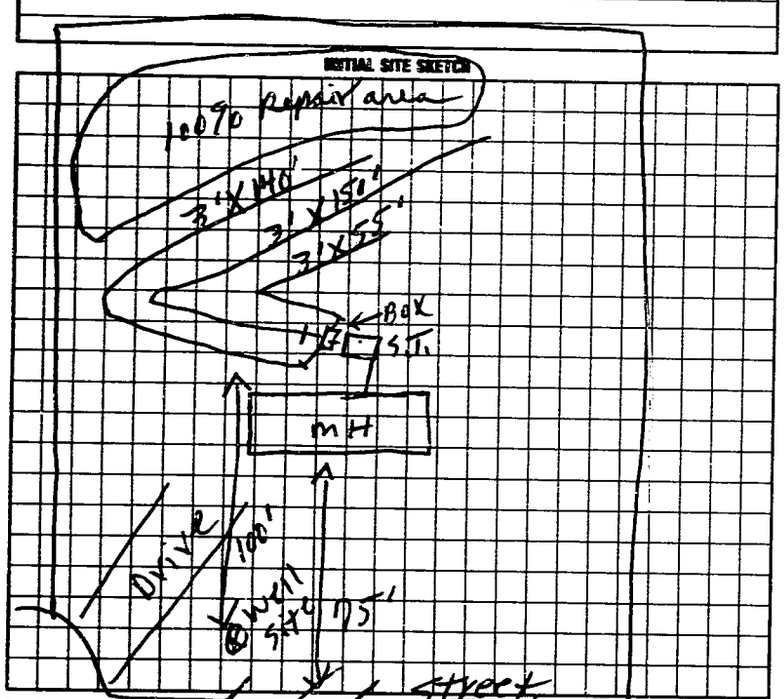

AS BUILT SKETCH

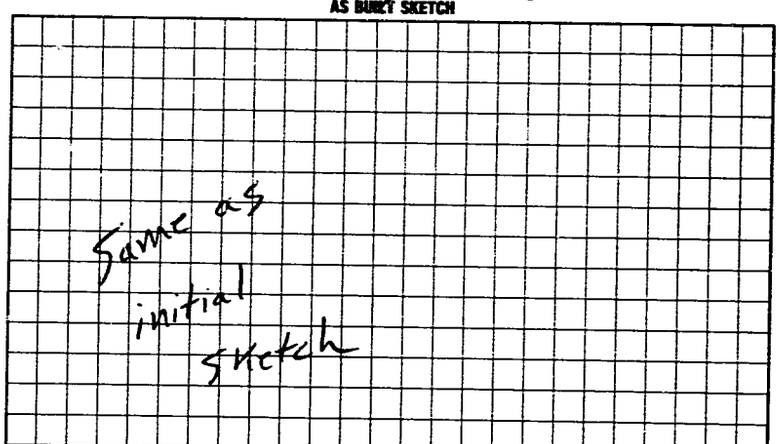

I understand that the permit can be suspended or revoked if any false information is supplied toward securing the permit/any unauthorized changes are made to the site/any unauthorized changes are made in the installation of the system. Improvement Permit is valid for 60 months from date of issuance.

Signed: _____

Improvement Permit by: P. C. moore date 11-17-93

Existing System Inspection by: _____ date _____

Installed by: Dellinger S.T.

Certificate of Completion by: P. C. moore date 12-2-93

Operation Permit by: _____ date _____

HEALTH DEPT. COPY: WHITE INSPECTION COPY (FINAL): GREEN OWNER COPY (FINAL): YELLOW INSPECTION COPY (INITIAL): PINK OWNER COPY (INITIAL): GOLD