IREDELL COUNTY HEALTH DEPARTMENT

STATESVILLE 704-878-5305 MOORESVILLE 704-664-5281

IMPROVEMENT PERMIT / AUTHORIZATION TO CONSTRUCT / OPERATION PERMIT / EXISTING SYSTEM INSPECTION

PERMIT# 106320 PIN# 4491-47-4356 DATE 5/24/02

OWNER OR CONTRACTOR Acadiana Investments PHONE Business (704) 529-4516 Home Oakwood Homes

ADDRESS 5551 Monroe Rd Charlotte, N.C. 28212

LOCATION Hwy 70 E to Triplett Rd, to end, Water moss to end, on Conglay 4th Lot on Left

SUBDIVISION Willow Ridge BLOCK / SECTION II LOT # 79 LOT AREA .813 Acres SITE CLASS I DESIGN FLOW 360 L.T.A.R. .35 gpd

EX Septic Tank: 4000 Gallons: STB 794 Date 11-8-93
Pump Tank: Gallons: PT Date
Pump Make: Model Serial No.
Nitrification Field: No Fields 1 Square Feet 1090 Linear Feet 350
No Lines 5 Trench Width 36" Max Trench Bottom Depth 34

New System / Repair System Type I II III IV V VI
System Description: Existing - Con. - Gravity
Repair System Description:
Maintenance Agreement Required: Yes X No

Gravel Depth 12" Slab X Crawl Space Basement w/plumbing Basement wo/plumbing

House/Mod. Home No. Bedrooms 3
X Mobile Home No. Bathrooms 2
Business No. Employees
Other


Water Supply: X Individual Public Community

Comments/Conditions:

Comments/Conditions: ① Keep min 5ft from S.T. and Existing Septic lines.
Existing System okay at time of inspection.
Original Permit #18033, Jeffrey Todd Shumaker - 4/5/94

INITIAL SITE SKETCH

AS BUILT SKETCH

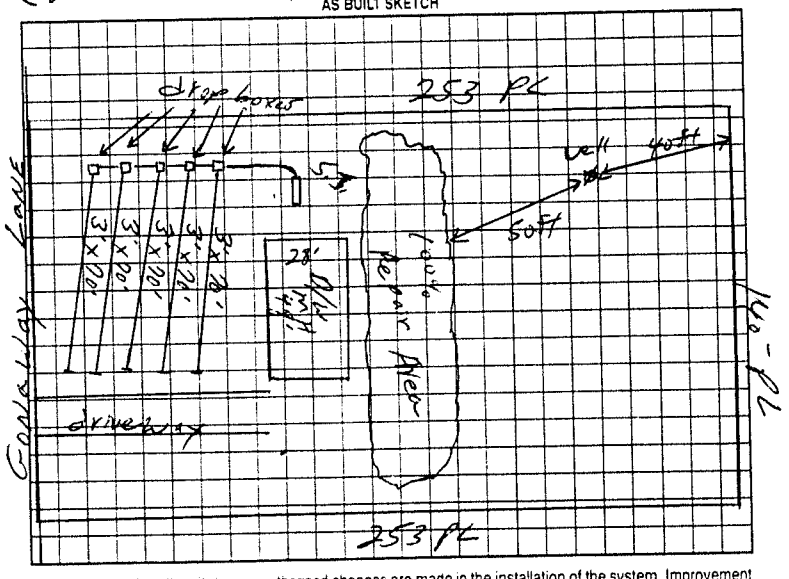

Permit can be suspended or revoked if any false information is supplied toward securing the permit/any unauthorized changes are made to the site/any unauthorized changes are made in the installation of the system. Improvement Permit with plat/valid without expiration. Improvement Permit with site plan valid for sixty months. Authorization to Construct is valid for a period equal to that of Improvement Permit – not to exceed sixty months

Signed: Larry W. Mosy date 5/23/02

Improvement Permit by: date

Authorization to Construct by: date

Installed by:

Operation Permit by: date

Existing System Inspection by: William O. Johnson date 5/20/02

HEALTH DEPT. COPY WHITE OWNER COPY (FINAL) YELLOW OWNER COPY (INITIAL) PINK