IREDELL COUNTY HEALTH DEPARTMENT

STATESVILLE 704-878-5305 MOORESVILLE 704-664-5281

IMPROVEMENT PERMIT / CERTIFICATE OF COMPLETION / OPERATION PERMIT / EXISTING SYSTEM INSPECTION

PROPERTY DESCRIPTION NO. 16937 DATE 9-2-93 TAX MAP NO. 5F-2-A-81

OWNER OR CONTRACTOR Kimberly G. Shew PHONE: Business Home 872-2612

ADDRESS (Rt 11 Box 430 Sta) LOCATION Hwy 70 E TR Triplett Rd TL water mass TL Goneaway Ct end

SUBDIVISION Willow Ridge BLOCK / SECTION 2 LOT 81 LOT AREA .92 acres SITE CLASS. PS L.T.A.R. .7

Water Supply: ☑ Individual ☐ Community ☐ Public

Septic Tank: 1250 Gallons; STB 31 Date 4-13-93

Pump Tank: _____ Gallons; PT _____ Date _____

Nitrification Field: No Fields 1 Square Feet 1200 Linear Feet 400

No Lines 4 Trench Width 36 Trench Depth 16to36 Gravel Depth 12

☑ New System ☐ Repair System Type: I, II, III, IV, V, VI

System Description: Conv. Gravity

Repair System Description: Conv. ~~Pressure~~ Gravity

Maintenance Agreement Required: ☐ Yes ☑ No

☑ ~~House~~/Mod. Home ☐ Mobile Home ☐ Business ☐ Other

No. Bedrooms 4 No. Bathrooms 2 No. Employees _____

☐ Slab ☑ Crawl Space ☐ Basement w/plumbing ☐ Basement wo/plumbing

Garbage Disposal: ☐ Yes ☑ No


Auto. Dishwasher: ☑ Yes ☐ No

Auto. Washing Machine: ☐ Yes ☐ No


Other _____

Comments MH + well not set at time of this inspection keep proper distances from S.T. system

INITIAL SITE SKETCH

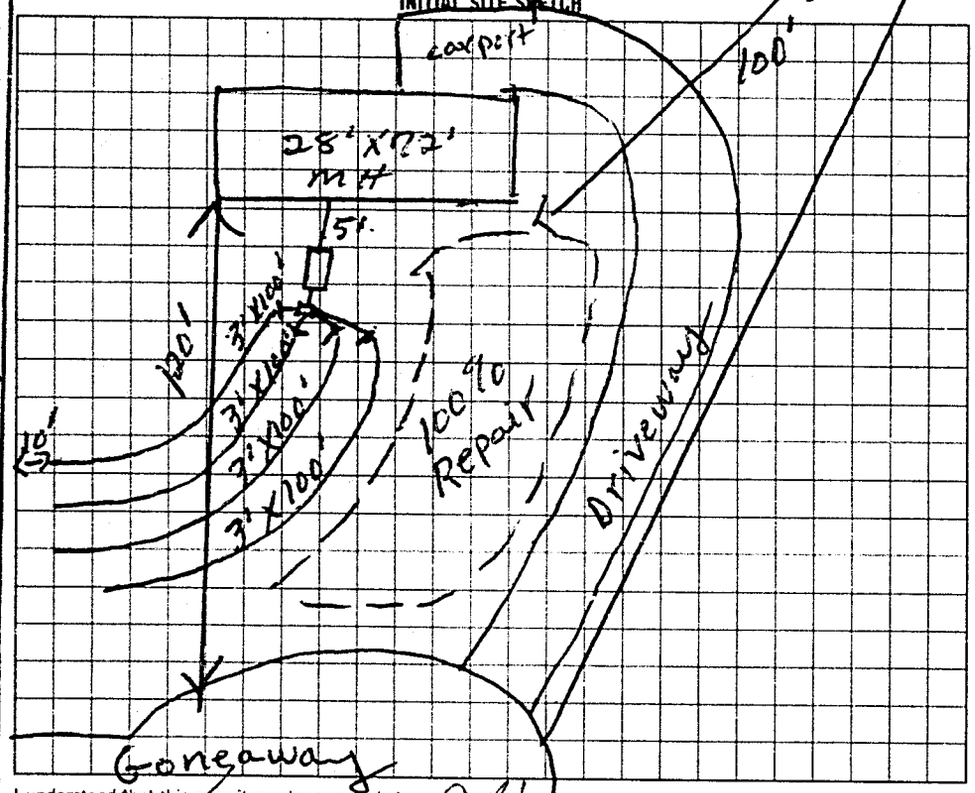

AS BUILT SKETCH

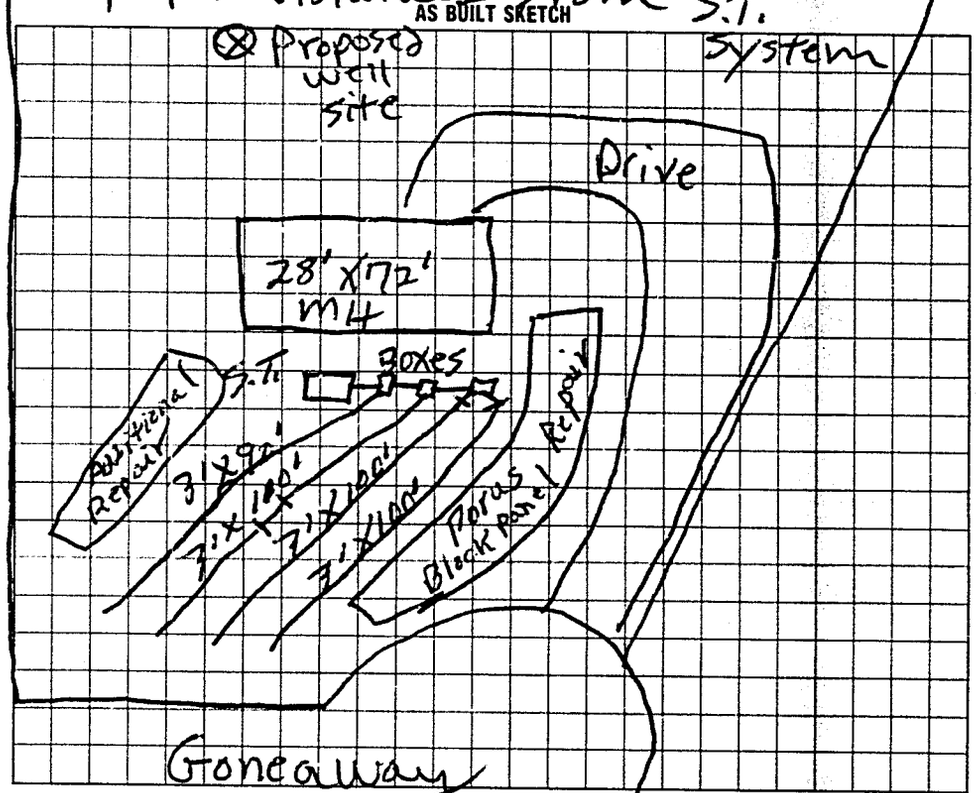

I understand that this permit can be suspended or revoked if any false information is supplied toward securing the permit/any unauthorized changes are made to the site/any unauthorized changes are made in the installation of the system. Improvement Permit is valid for 60 months from date of issuance.

Signed: x Kimberly G Shew

Improvement Permit by: E.C. Moore date 9-2-93

Existing System Inspection by: _____ date _____

Installed by: James Huddleston

Certificate of Completion by: E.C. Moore date 7-1-94

Operation Permit by: _____ date _____

HEALTH DEPT. COPY: WHITE INSPECTION COPY (FINAL): GREEN OWNER COPY (FINAL): YELLOW INSPECTION COPY (INITIAL): PINK OWNER COPY (INITIAL): GOLD

8 2 2 2 0 0