IREDELL COUNTY HEALTH DEPARTMENT

STATESVILLE 704-878-5305 MOORESVILLE 704-664-5281

IMPROVEMENT PERMIT / CERTIFICATE OF COMPLETION / OPERATION PERMIT / EXISTING SYSTEM INSPECTION

PROPERTY DESCRIPTION NO. 16860 DATE 8-25-93

OWNER OR CONTRACTOR April Norman PHONE: Business Home 878-9241

ADDRESS 433 Dogwood Est TAX MAP NO.

LOCATION 70E TR Triplett Rd 4mi Stat. 4mi TL water moss at ent TL Going-Away at end

SUBDIVISION Willow Ridge BLOCK / SECTION II LOT 82 LOT AREA 3.69 acres SITE CLASS. PS L.T.A.R. .35

Water Supply: ☑ Individual ☐ Community ☐ Public

Septic Tank: 1000 Gallons; STB 358 Date 8-10-93

Pump Tank: Gallons; PT Date

Nitrification Field: No Fields 1 Square Feet 1035 Linear Feet 345

No Lines 3 Trench Width 36 Trench Depth 18/36 Gravel Depth 12

☑ New System ☐ Repair System Type: I (II.) III. IV. V. VI

System Description: Conventional

Repair System Description:

Maintenance Agreement Required: ☐ Yes ☑ No

☐ House/Mod. Home ☑ Mobile Home ☐ Business ☐ Other

No. Bedrooms 3 No. Bathrooms 2 No. Employees

Garbage Disposal: ☐ Yes ☑ No

Auto. Dishwasher: ☐ Yes ☑ No


Auto. Washing Machine: ☐ Yes ☐ No

Other


☐ Slab ☑ Crawl Space ☐ Basement w/plumbing ☐ Basement wo/plumbing

Comments well + Home not located at time of this inspection. Place at Projected locations shown below + at Proper distances from S.T. System

INITIAL SITE SKETCH

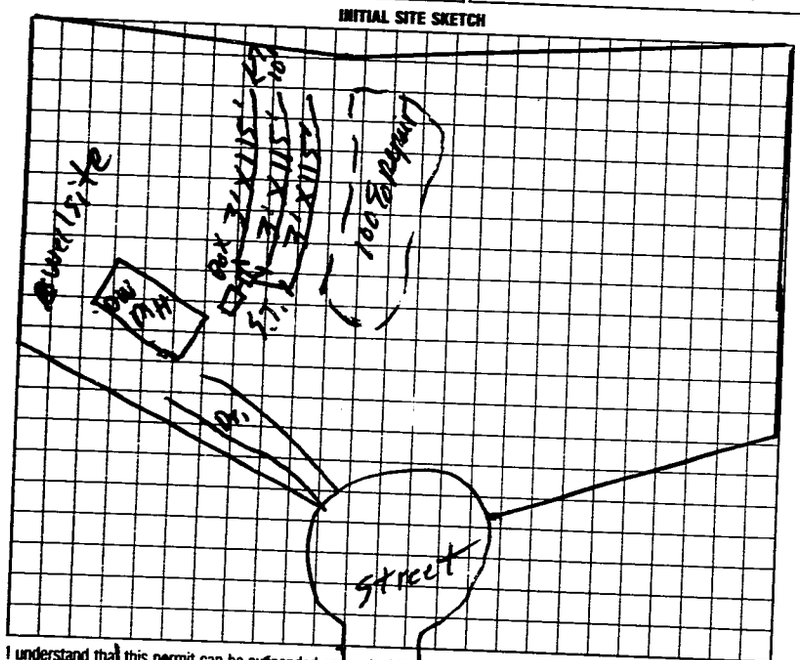

AS BUILT SKETCH

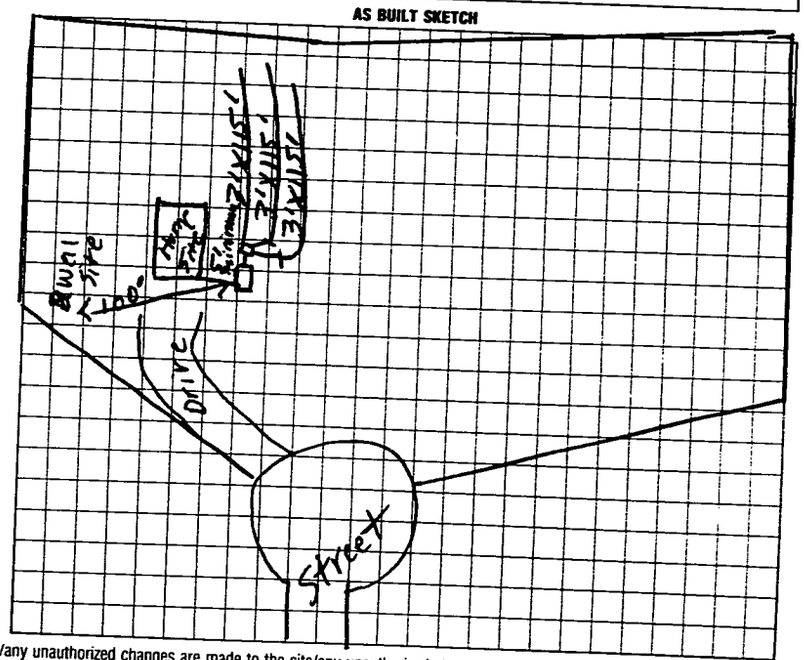

I understand that this permit can be suspended or revoked if any false information is supplied toward securing the permit/any unauthorized changes are made to the site/any unauthorized changes are made in the installation of the system Improvement Permit is valid for 60 months from date of issuance.

Signed: x April E. Norman

Improvement Permit by: J. C. Moore date 8-25-93

Existing System Inspection by: date

Installed by: A-1 Backhoe

Certificate of Completion by: J. C. Moore date 9-23-93

Operation Permit by: date

HEALTH DEPT. COPY: WHITE INSPECTION COPY (FINAL): GREEN OWNER COPY (FINAL): YELLOW INSPECTION COPY (INITIAL): PINK OWNER COPY (INITIAL): GOLD