4771515972

IREDELL COUNTY HEALTH DEPARTMENT

STATESVILLE 704-878-5305 MOORESVILLE 704-664-5281

IMPROVEMENT PERMIT / CERTIFICATE OF COMPLETION / OPERATION PERMIT / EXISTING SYSTEM INSPECTION

PROPERTY DESCRIPTION NO. REPAIR DATE 1-20-96 TAX MAP NO. Watershed: ☐ Yes ☐ No

OWNER OR CONTRACTOR ALLEN COOK PHONE: Business Home 528-3175

ADDRESS 191 COTTONWOOD, CLEVELAND, NC 27013

LOCATION US 21 N, TR OSWALT SMITH, TR COTTONWOOD LAST HOUSE ON LEFT (BOX 191)

SUBDIVISION BLOCK / SECTION LOT LOT AREA 1 AMPLE SITE CLASS. PS DESIGN FLOW 360 L.T.A.R. EXISTING

Septic Tank: EXISTING Gallons; STB Date

Pump Tank: Gallons; PT Date

Pump Make: Model Serial No.

Nitrification Field: No Fields 1 Square Feet 450 Linear Feet 75

No Lines 1 BED Trench Width 72" Max Trench Bottom Depth 36" Gravel Depth (24")

☐ New System ☑ Repair System Type: I, (II), III, IV, V, VI

System Description: CONV. GRAVITY

Repair System Description: CONV. GRAVITY

Maintenance Agreement Required: ☐ Yes ☑ No

☑ House/Mod. Home No. Bedrooms 3

☐ Mobile Home No. Bathrooms

☐ Business No. Employees

☐ Other


☐ Slab ☑ Crawl Space ☐ Basement w/plumbing ☐ Basement wo/plumbing

Water Supply:
☑ Individual
☐ Community
☐ Public
WELL

Comments: (1) INSTALL NEW DISTRIBUTION BOX AT LOCATION SHOWN (2) INSTALL NEW 6' X 75' BED USING 24" STONE. (3) TIE IN EXISTING DRAIN LINES.

Comments:

INITIAL SITE SKETCH

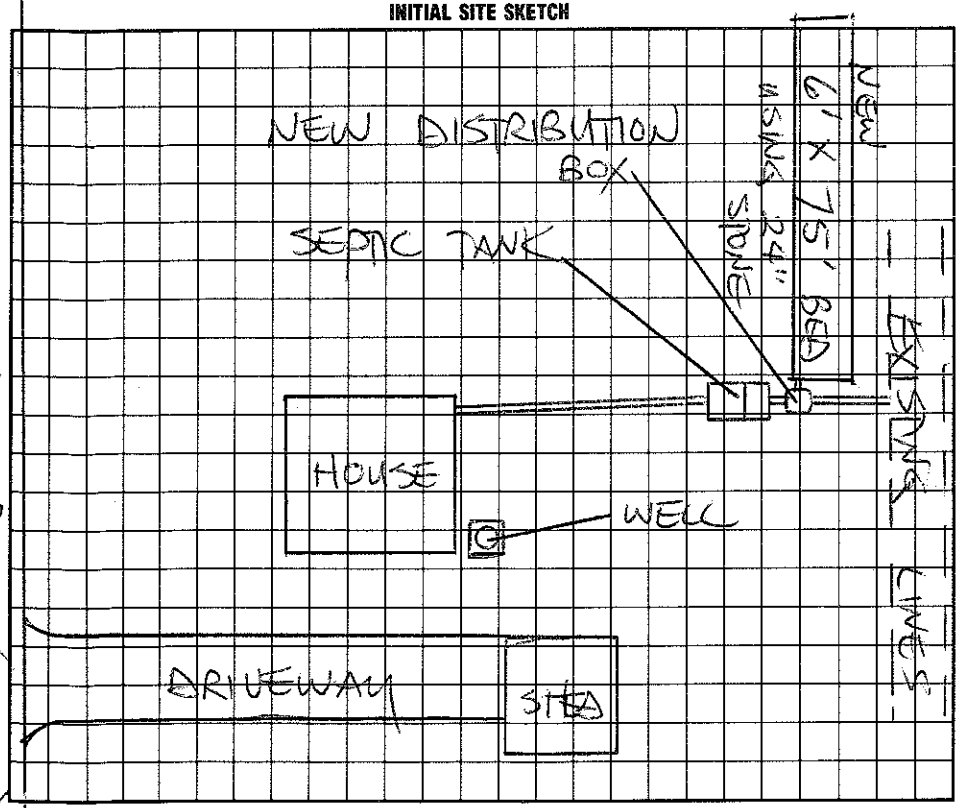

AS BUILT SKETCH

I understand that this permit can be suspended or revoked if any false information is supplied toward securing the permit/any unauthorized changes are made to the site/any unauthorized changes are made in the installation of the system.

AUTHORIZATION TO CONSTRUCT IS VALID FIVE (5) YEARS FROM DATE OF ISSUANCE. IMPROVEMENT PERMIT HAS NO EXPIRATION DATE.

Signed: A. Allen D. Cook

Installed by: James Hurdle Lee

Improvement Permit by: STEVE HEDRICK date 1-20-96

AUTHORIZATION TO CONSTRUCT Existing System Inspection by: STEVE HEDRICK date 1-20-96

Certificate of Completion by: date

Operation Permit by: Wesley Sparks R.S. date 2/27/96

HEALTH DEPT. COPY: WHITE INSPECTION COPY (FINAL): GREEN OWNER COPY (FINAL): YELLOW INSPECTION COPY (INITIAL): PINK OWNER COPY (INITIAL): GOLD