IREDELL COUNTY HEALTH DEPARTMENT

STATESVILLE 704-878-5305 MOORESVILLE 704-664-5281

IMPROVEMENT PERMIT / AUTHORIZATION TO CONSTRUCT / OPERATION PERMIT / EXISTING SYSTEM INSPECTION

PERMIT# 137869 PIN# 4771-54-9460 DATE 09/06/06

OWNER OR APPLICANT GAIL BEAVER PHONE: Business 704-528-3210 Home

ADDRESS 1707 OSTWALT AMITY RD. CLEVELAND, NC 27013

LOCATION DEFAULT AMITY RD. EAST, ON LEFT @ ROWAN Co. LINE, @ BOX # 1707.

SUBDIVISION N/A BLOCK / SECTION — LOT — LOT AREA 1.5+ ACRES SITE CLASS. EXIST. DESIGN FLOW 360 GPD L.T.A.R. EXIST.

Septic Tank: ~1,000 Gallons: STB Date

Pump Tank: Gallons: PT Date

Pump Make: Model Serial No.

Nitrification Field: No Fields 1 Square Feet ~720 Linear Feet ~240'

No Lines 3 @ ~80' Trench Width ~36" Max Trench Bottom Depth ?

☐ New System ☐ Repair ☐ Expansion System Type: I II III IV V VI

System Description: CONV. , GRAVITY

Repair System Description:

Maintenance Agreement Required: ☐ Yes ☒ No

Gravel Depth ? ☒ Gravity ☐ Pressure ☐ Slab ☒ Crawl Space ☐ Basement w/plumbing ☐ Basement wo/plumbing

☐ House/Mod. Home No. Bedrooms 3

☒ Mobile Home No. Persons

☐ Business No. Employees

☐ Other


Water Supply: ☒ Individual WELL ☐ Public ☐ Community

Comments:/Conditions:


Comments:/Conditions:

* RECOMMEND PUMPING SEPTIC TANK, IF NOT DONE RECENTLY.
* NO VEHICLE TRAFFIC OVER SYSTEM AREA.

INITIAL SITE SKETCH

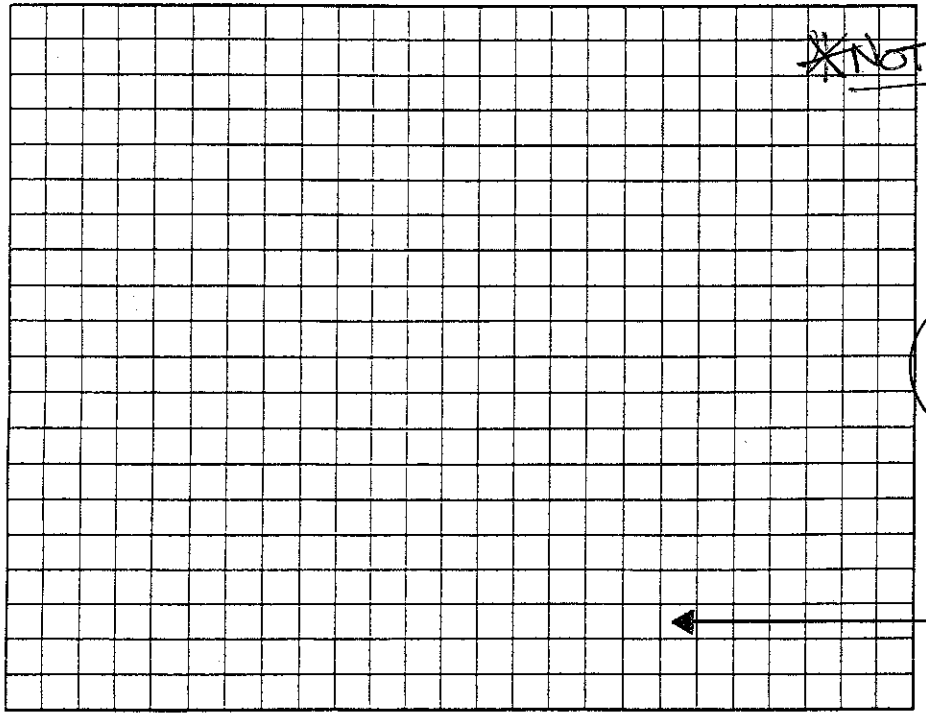

AS BUILT SKETCH

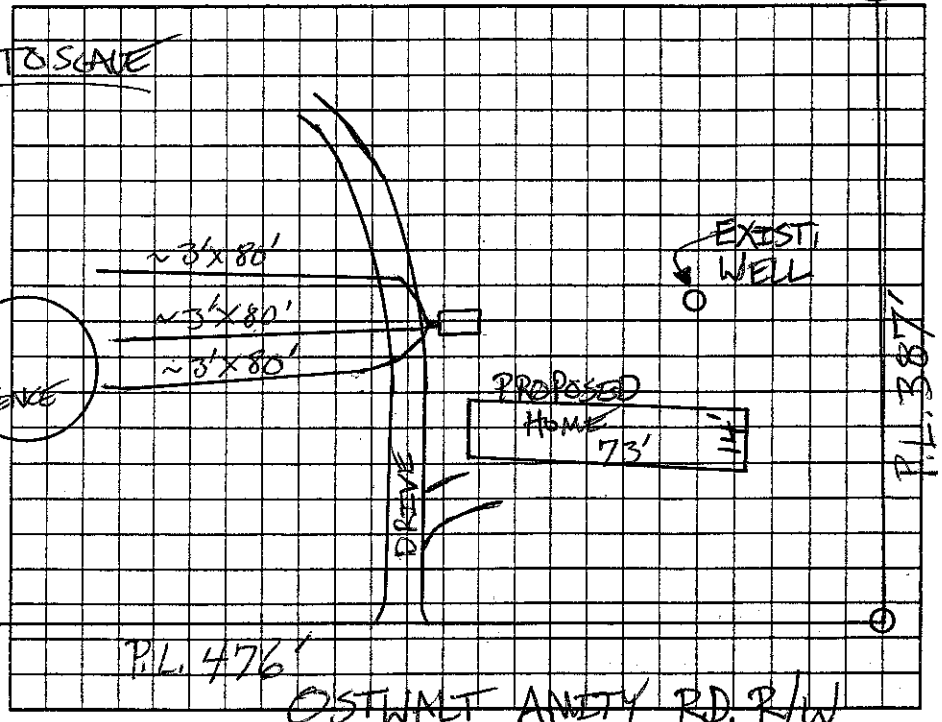

Permit can be suspended or revoked if any false information is supplied toward securing the permit/any unauthorized changes are made to the site/any unauthorized changes are made in the installation of the system. Improvement Permit with plat valid without expiration ☐ Improvement Permit with site plan valid for sixty months ☐ Authorization to Construct is valid for a period equal to that of Improvement Permit – not to exceed sixty months.

Signed: date Installed by:

Improvement Permit by: date Operation Permit by: date

Authorization to Construct by: date Existing System Inspection by: date 09/06/06

HEALTH DEPT. COPY: WHITE OWNER COPY (FINAL): YELLOW OWNER COPY (INITIAL): PINK