3:30

IREDELL COUNTY HEALTH DEPARTMENT

STATESVILLE 704-878-5305 MOORESVILLE 704-664-5281

IMPROVEMENT PERMIT / AUTHORIZATION TO CONSTRUCT / OPERATION PERMIT / EXISTING SYSTEM INSPECTION

PERMIT # 154477 PIN # 4771-62-3943 DATE 2-2-09

OWNER or APPLICANT MICHAEL SCHMIDT PHONE: Business 704-962-9249 Home:

OWNER or APPLICANT ADDRESS 308 OLD COUNTY RD CLEVELAND NC 27013

LOCATION / DIRECTIONS OSWALT AMITY, PAST COUNTY LINE, TR OLD COUNTY, TR @ 308 + FOLLOW DIRT RD TO END

SUBDIVISION — BLOCK / SECTION — LOT # — LOT AREA 3.25 DESIGN FLOW 240 L.T.A.R. .25/.2

Septic Tank 1000 Gallons: STB 1000 Date 3-17-09
Pump Tank — Gallons: P T Date —
Pump Make — Model — Serial # —
Nitrification Field No Fields 1 No Lines 2 Linear Feet 250'
Trench Width 36" Max. Trench Bottom Depth 18" Gravel Depth —

☒ New System ☐ Repair ☐ Expansion System Type I (II) III IV V VI
System Description: SHALLOW GRAV. 25%
Repair System Description: SAME (.2 LTAR)
Maintenance Agreement Required ☐ YES ☒ NO
☒ GRAVITY ☐ PRESSURE


☒ Residence No. Bedrooms 1
☐ Business No. Persons 1
☐ Other No. Employees —
☐ Slab ☒ Crawl Space
☐ Basement w/plumbing ☐ Basement w/o plumbing

Water Supply: ☒ Private ☐ Public ☐ Community


Comments / Conditions

Comments / Conditions 1) MEET ALL SET RACKS 2) 18" TRENCH BOTTOM BECAUSE OF SOIL ISSUES

INITIAL SITE SKETCH

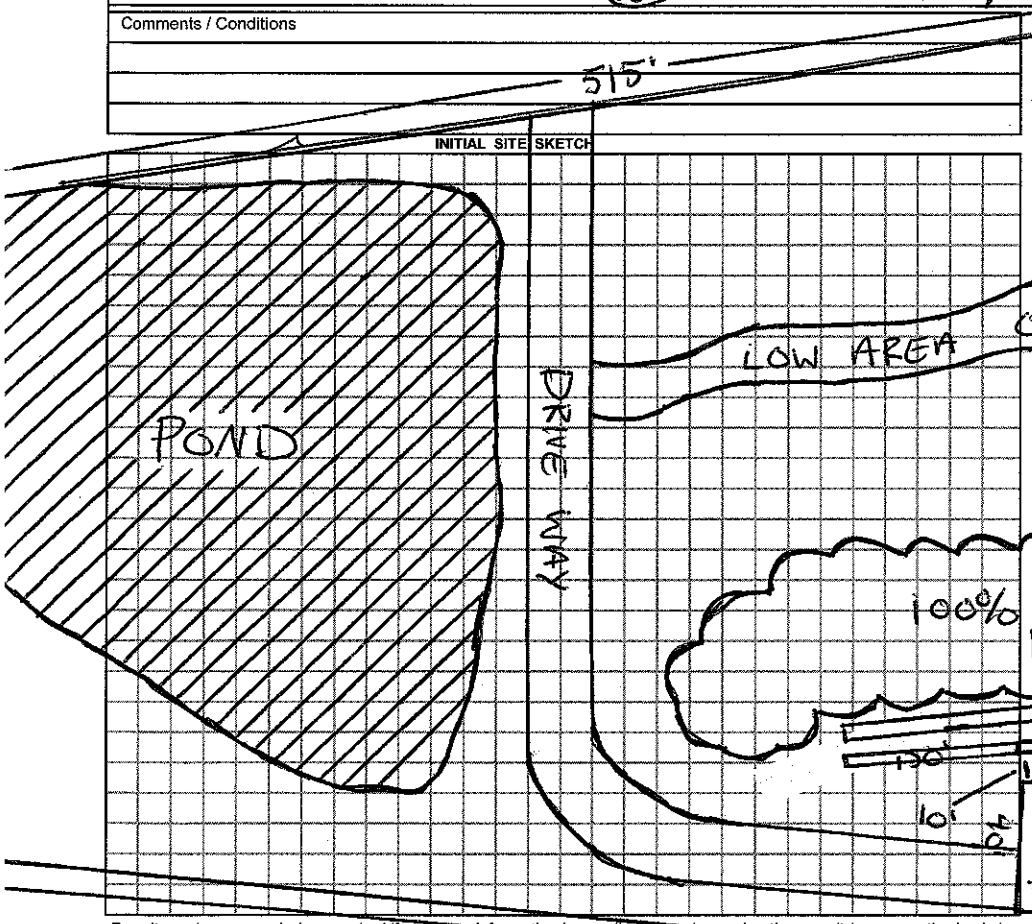

AS BUILT SKETCH

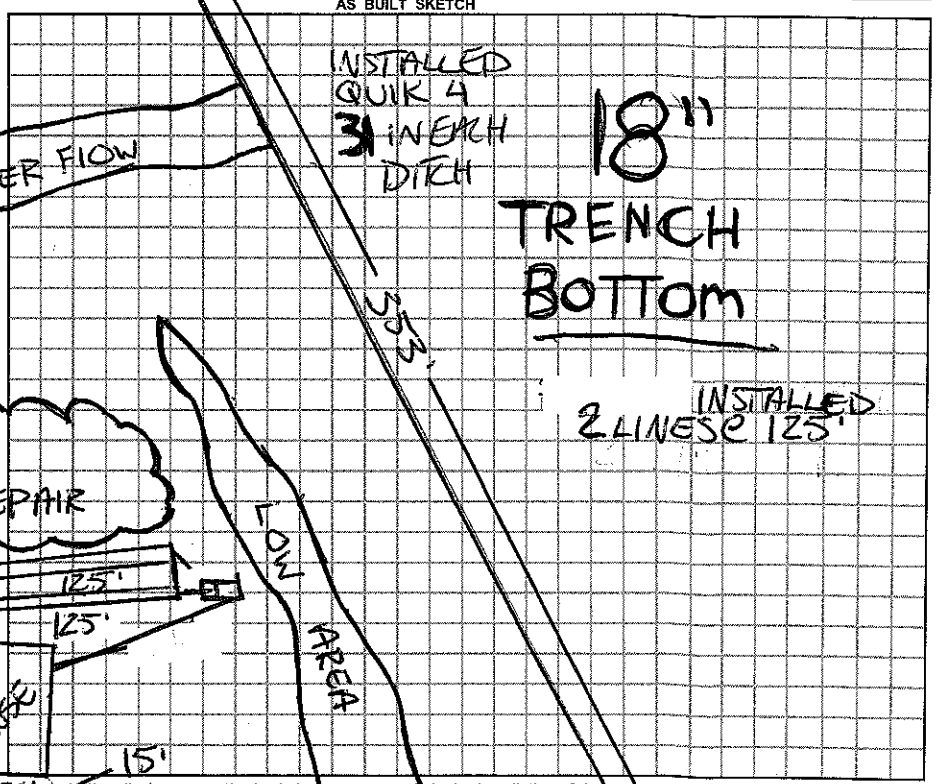

Permit can be suspended or revoked if any false information is supplied toward securing the permit / any unauthorized changes are made to the site / any unauthorized changes are made in the installation of the system.

☐ *IMPROVEMENT PERMIT w / plat valid without expiration.* ☐ *IMPROVEMENT PERMIT w / site plan valid for 60 mos.* ☒ *AUTHORIZATION TO CONSTRUCT valid for period equal to IMPROVEMENT PERMIT-not to exceed 60 mo.*

Owner / Applicant Signature: [signature] Date 2-5-09 Installed by: [signature]

Improvement Permit by: [signature] Date 2-2-09 Operation Permit by: [signature] Date: 5-20-09

Authorzation to Construct by: [signature] Date 2-2-09 Existing System Inspected by: Date:

YOU SHOULD CONTACT A LOCATOR SERVICE PRIOR TO ANY EXCAVATION.

WHITE COPY Environmental Health YELLOW COPY (Final) Owner / Applicant PINK COPY (Initial) Owner / Applicant