# IREDELL COUNTY HEALTH DEPARTMENT

STATESVILLE 704-878-5305 MOORESVILLE 704-664-5281

## IMPROVEMENT PERMIT / AUTHORIZATION TO CONSTRUCT / OPERATION PERMIT / EXISTING SYSTEM INSPECTION

PERMIT# 173065 PIN# 4777 66 5672 DATE 4-23-98

OWNER OR CONTRACTOR Shirley Heglar PHONE: Business Home 278 4380

ADDRESS 4520 Amity Hill Rd Cleveland N.C.

LOCATION 70 E TR Triplett Rd TL Oswalt Amity at Rowan Co Line TL Private Dr.

SUBDIVISION BLOCK / SECTION LOT LOT AREA 160 acres+ SITE CLASS. PS DESIGN FLOW 240 L.T.A.R. .3

Septic Tank: 1000 Gallons; STB 825 Date 5-1-98

Pump Tank: Gallons; PT Date

Pump Make: Model Serial No.

Nitrification Field: No Fields 1 Square Feet 810 Linear Feet 270

No Lines 3 Trench Width 36" Max Trench Bottom Depth 36" Gravel Depth 12"

☑ New System ☐ Repair System Type: I, II, III, IV, V, VI

System Description: Conv. Gravity

Repair System Description: " "

Maintenance Agreement Required: ☐ Yes ☐ No

☐ House/Mod. Home ☑ Mobile Home ☐ Business ☐ Other

No. Bedrooms 2 No. Bathrooms 2 No. Employees


☐ Slab ☐ Crawl Space ☐ Basement w/plumbing ☐ Basement wo/plumbing

Water Supply: ☑ Individual ☐ Public ☐ Community well next door

Comments:/Conditions:


Heath Heglar Property

**INITIAL SITE SKETCH**

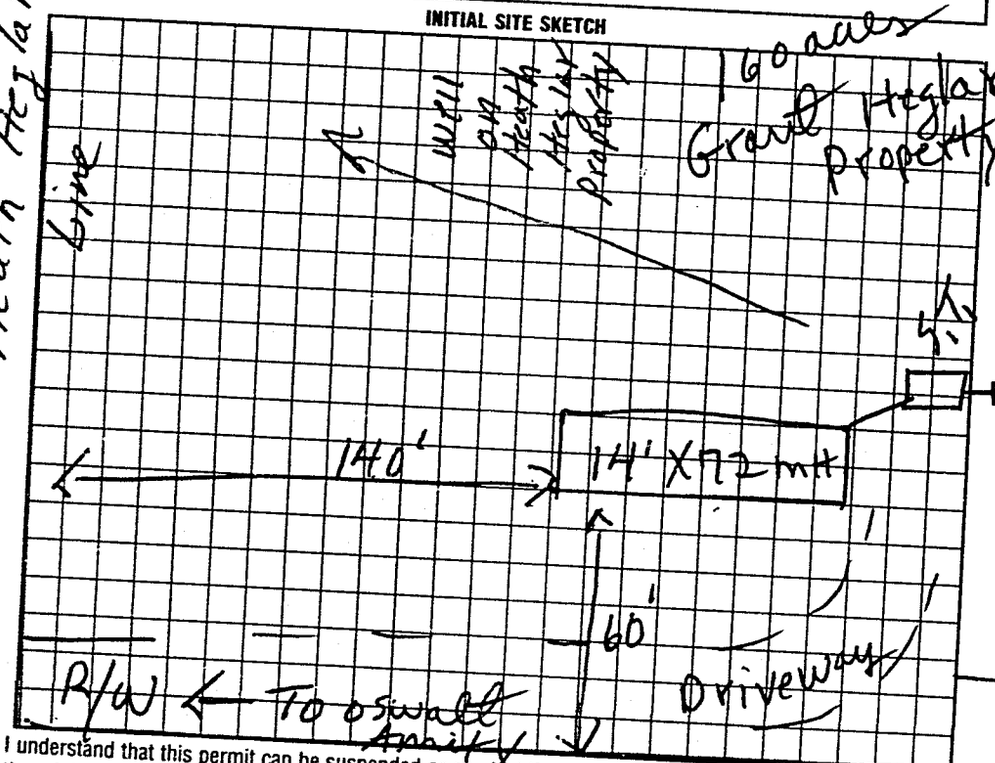


Comments:/Conditions:

**AS BUILT SKETCH**

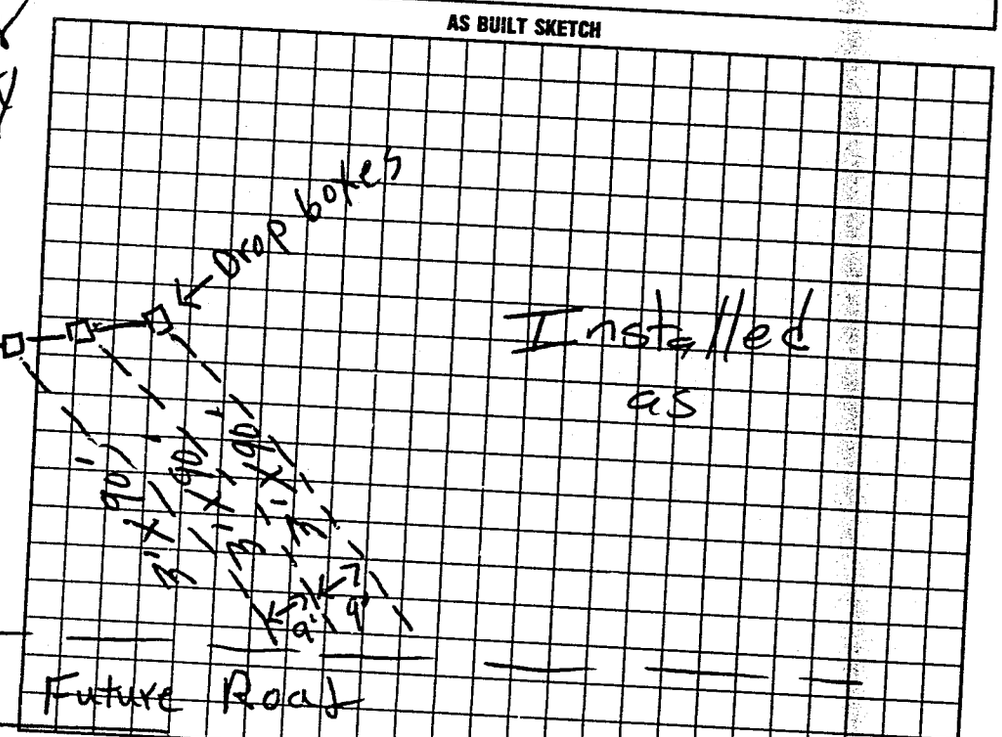


I understand that this permit can be suspended or revoked if any false information is supplied toward securing the permit/any unauthorized changes are made to the site/any unauthorized changes are made in the installation of the system. Improvement Permit with plat valid without expiration. Improvement Permit with site plan valid for sixty months. Authorization to Construct is valid for a period equal to that of Improvement Permit – not to exceed sixty months. Bill Upright property line

Signed: Shirley B. Heglar date

Improvement Permit by: C. C. Moore date 4-23-98

Authorization to Construct by: C. C. Moore date 4-23-98

Installed by: Heglar (self)

Operation Permit by: Mark Cox RS date 6-24-98

Existing System Inspection by: date

HEALTH DEPT. COPY: WHITE INSPECTION COPY (FINAL): GREEN OWNER COPY (FINAL): YELLOW INSPECTION COPY (INITIAL): PINK OWNER COPY (INITIAL): GOLD