IREDELL COUNTY HEALTH DEPARTMENT

STATESVILLE 704-878-5305 MOORESVILLE 704-664-5281

IMPROVEMENT PERMIT / AUTHORIZATION TO CONSTRUCT / OPERATION PERMIT / EXISTING SYSTEM INSPECTION

PERMIT# 136524 PIN# 4771-66-2845 ~~4771-54-6729~~ DATE 07/12/06

OWNER OR APPLICANT RANDY BEAVER PHONE: Business _____ Home 704-528-3210

ADDRESS 1707 OSTWALT AMITY RD, CLEVELAND, NC 27013

LOCATION HWY 70 E, (R) TRIPLETT RD, (L) OSTWALT AMITY RD, (L) POOR BOY DR., @ END. (152 POOR BOY DR.)

SUBDIVISION N/A BLOCK / SECTION — LOT — LOT AREA 144.7 ACRES SITE CLASS. PS DESIGN FLOW 360 GPD L.T.A.R. 0.30 GPD/Ft²

EXIST. Septic Tank: 1,000 Gallons; STB _____ Date _____

Pump Tank: _____ Gallons; PT _____ Date _____

Pump Make: _____ Model _____ Serial No. _____

Nitrification Field: No Fields 1 Square Feet EQ to 600 Linear Feet 150'

No Lines 2@75' Trench Width 36" Max Trench Bottom Depth 36"

☒ New System ☐ Repair ☐ Expansion System Type: I II III IV V VI

System Description: 25% REDUCTION, GRAVITY

Repair System Description: CONV., GRAVITY

Maintenance Agreement Required: ☐ Yes ☒ No

Gravel Depth N/A ☒ Gravity ☐ Pressure ☐ Slab ☒ Crawl Space ☐ Basement w/plumbing ☐ Basement wo/plumbing

☐ House/Mod. Home No. Bedrooms 3

☒ Mobile Home No. Persons ____

☐ Business No. Employees ____

☐ Other _____

Water Supply: EXIST.


☒ Individual WELL (SHARED)

☐ Public


☐ Community

Comments/Conditions: (1) PLACE "T" AND FILTER IN SEPTIC TANK IF NOT ONE IN PLACE, (2) IF NEW PROPERTY LINES ARE CREATED, THEY MUST BE 10'+ FROM ANY PART OF SEPTIC OR REPAIR AREA. (3) KEEP (2) NEW LINES 15'+ UPSLOPE FROM SUSPECT FILL AREA. (4) USE SPEED LEVELERS ON ALL 4 LINES.

INITIAL SITE SKETCH

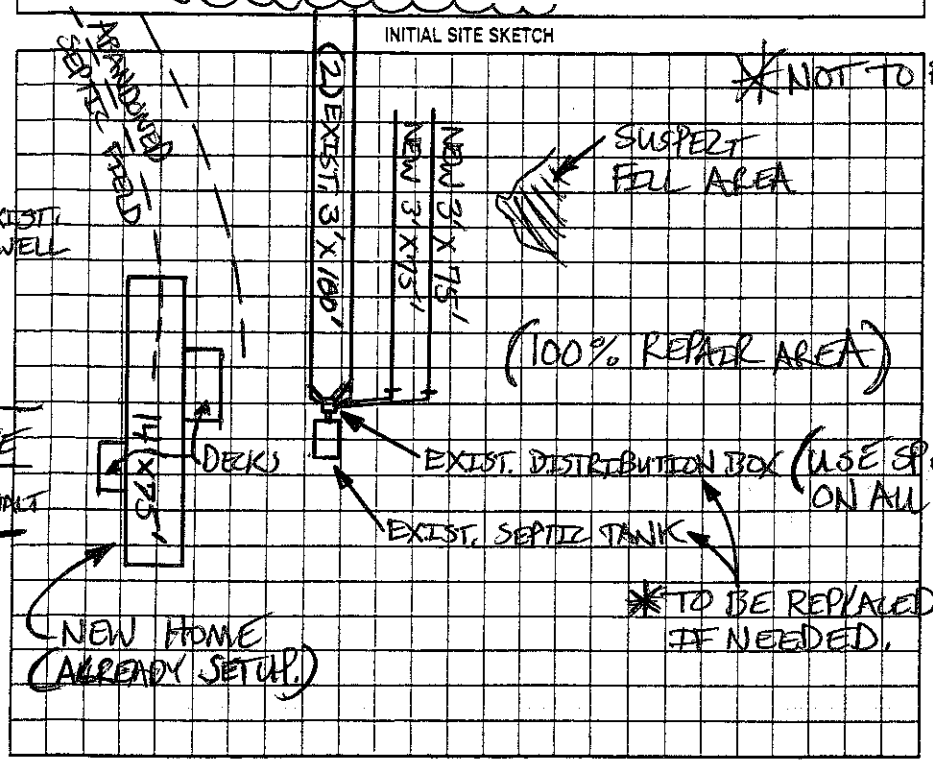

AS BUILT SKETCH

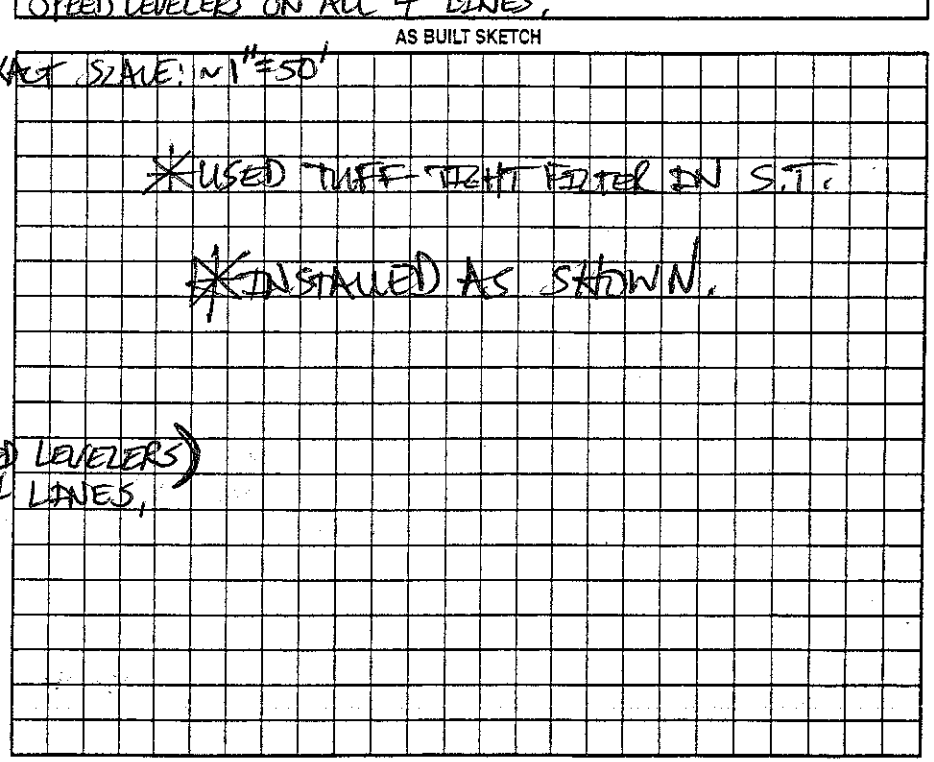

Permit can be suspended or revoked if any false information is supplied toward securing the permit/any unauthorized changes are made to the site/any unauthorized changes are made in the installation of the system. Improvement Permit with plat valid without expiration. ☐ Improvement Permit with site plan valid for sixty months ☒ Authorization to Construct is valid for a period equal to that of Improvement Permit – not to exceed sixty months.

Signed: Randy Beaver date _____

Improvement Permit by: Patrick Mitchell date 07/12/06

Authorization to Construct by: Patrick Mitchell date 07/12/06

Installed by: RANDY BEAVER (HOME OWNER)

Operation Permit by: Patrick Mitchell date 08/28/06

Existing System Inspection by: _____ date _____

HEALTH DEPT. COPY: WHITE OWNER COPY (FINAL): YELLOW OWNER COPY (INITIAL): PINK