IREDELL COUNTY HEALTH DEPARTMENT

STATESVILLE 704-878-5305 MOORESVILLE 704-664-5281

IMPROVEMENT PERMIT / AUTHORIZATION TO CONSTRUCT / OPERATION PERMIT / EXISTING SYSTEM INSPECTION

PERMIT# 78775 PIN# 4772216800 PT DATE 1-15-99

OWNER OR CONTRACTOR Mark B. Jones PHONE: Business Home 855 5569

ADDRESS 180 Karrimont Rd Mooresville, N.C.

LOCATION 70 East TR Triplett Rd TR Branch Rd atent

SUBDIVISION Amity Hill Est BLOCK / SECTION LOT 16 LOT AREA .9305 SITE CLASS DESIGN FLOW 360 L.T.A.R. .3

Septic Tank: 1000 Gallons; STB 825 Date 3-14-99
Pump Tank: Gallons; PT Date
Pump Make: Model Serial No
Nitrification Field: No Fields 1 Square Feet 630 Linear Feet 210
No Lines 3 Trench Width 36" Max Trench Bottom Depth 36" Gravel Depth N/A

☑ New System ☐ Repair System Type: I, II, III, IV, V, VI
System Description: Gravity Panels
Repair System Description: Pump To Panels
Maintenance Agreement Required: ☐ Yes ☑ No


☐ House/Mod. Home ☑ Mobile Home ☐ Business ☐ Other
No. Bedrooms 3 No. Bathrooms 2 No Employees
☐ Slab ☑ Crawl Space ☐ Basement w/plumbing ☐ Basement wo/plumbing

Water Supply: ☐ Individual ☐ Public ☑ Community

Comments/Conditions:
Dist Box with spoke levelers 394'

Comments /Conditions
Same as initial Sketch

INITIAL SITE SKETCH

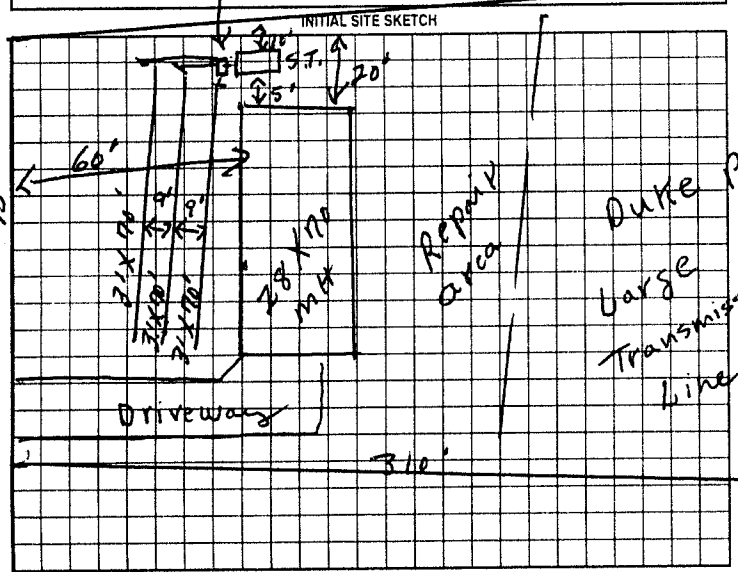

AS BUILT SKETCH

Permit can be suspended or revoked if any false information is supplied toward securing the permit/any unauthorized changes are made to the site/any unauthorized changes are made in the installation of the system. Improvement Permit with plat valid without expiration. Improvement Permit with site plan valid for sixty months. Authorization to Construct is valid for a period equal to that of Improvement Permit – not to exceed sixty months.

Signed: Mark B. Jones date 1-28-99 Installed by: Upright Grading

Improvement Permit by: J. C. Moore date 1-15-99 Operation Permit by: J. C. Moore date 4-21-99

Authorization to Construct by: J. C. Moore date 1-15-99 Existing System Inspection by: date

HEALTH DEPT. COPY: WHITE OWNER COPY (FINAL) YELLOW OWNER COPY (INITIAL) PINK