IREDELL COUNTY HEALTH DEPARTMENT

STATESVILLE 704-878-5305 MOORESVILLE 704-664-5281

IMPROVEMENT PERMIT / AUTHORIZATION TO CONSTRUCT / OPERATION PERMIT / EXISTING SYSTEM INSPECTION

PERMIT# 80730 PIN# 4772223258 DATE 4-29-99

OWNER OR CONTRACTOR David Slack PHONE: Business _____ Home 704 775 1906

ADDRESS 6391 Hanna CT Lot 54 Harrisburg N.C.

LOCATION 70 E to Triplett Rd to R Branch to R Hearsans 2nd lot left

SUBDIVISION Amity Hill Est. BLOCK / SECTION _____ LOT 15 LOT AREA .71 acres SITE CLASS PS DESIGN FLOW 360 L.T.A.R. .3

Septic Tank: 1060 Gallons; STB 760 Date 5-18-99
Pump Tank: _____ Gallons; PT _____ Date _____
Pump Make: _____ Model _____ Serial No. _____
Nitrification Field: No Fields 1 Square Feet 400 Linear Feet 200
No Lines 3 Trench Width 24" Max Trench Bottom Depth 36" Gravel Depth N/A

☑ New System ☐ Repair System Type: I, II, III, IV, V, VI
System Description: Gravity Panels
Repair System Description: _____
Maintenance Agreement Required: ☐ Yes ☑ No

☐ House/Mod. Home ☑ Mobile Home ☐ Business ☐ Other
No. Bedrooms 3 No. Bathrooms 2 No. Employees _____


☐ Slab ☑ Crawl Space ☐ Basement w/plumbing ☐ Basement wo/plumbing

Water Supply: ☐ Individual ☐ Public ☑ Community


Comments/Conditions:

Comments/Conditions
Divert Surface water
PL 310

INITIAL SITE SKETCH

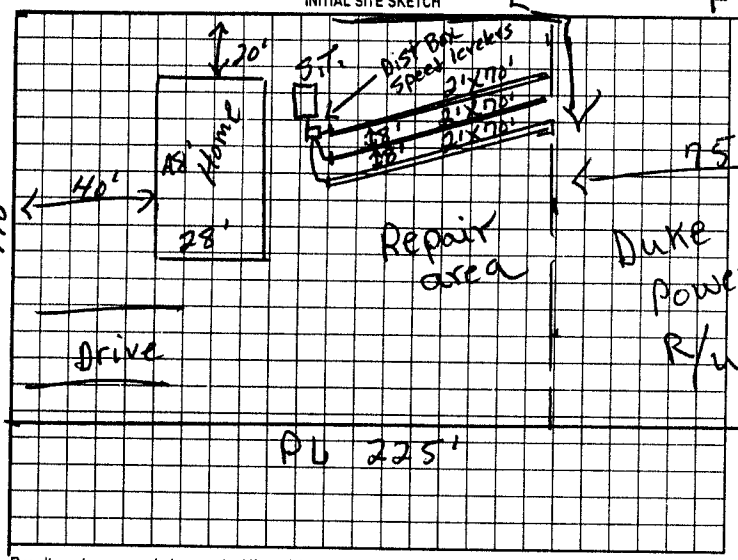

AS BUILT SKETCH

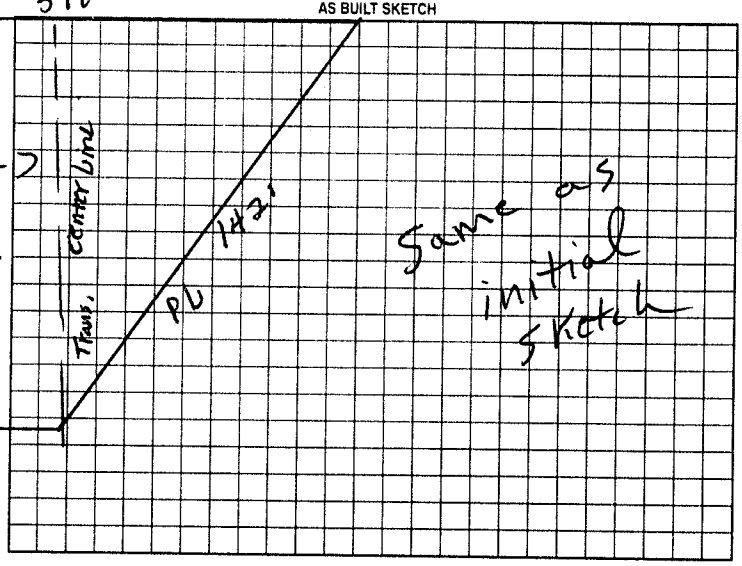

Permit can be suspended or revoked if any false information is supplied toward securing the permit/any unauthorized changes are made to the site/any unauthorized changes are made in the installation of the system. Improvement Permit with plat valid without expiration. Improvement Permit with site plan valid for sixty months. Authorization to Construct is valid for a period equal to that of Improvement Permit – not to exceed sixty months.

Signed: David Slack date 5-02-99 Installed by: Upright Grading

Improvement Permit by: J.C. Moore date 4-29-99 Operation Permit by: J.C. Moore date 9-20-99

Authorization to Construct by: J.C. Moore date 4-29-99 Existing System Inspection by: _____ date _____

HEALTH DEPT. COPY: WHITE OWNER COPY (FINAL): YELLOW OWNER COPY (INITIAL): PINK