IREDELL COUNTY HEALTH DEPARTMENT

STATESVILLE 704-878-5305 MOORESVILLE 704-664-5281

IMPROVEMENT PERMIT / AUTHORIZATION TO CONSTRUCT / OPERATION PERMIT / EXISTING SYSTEM INSPECTION

PERMIT# 34047 PIN# 4777222 5183 DATE 9-30-99

OWNER OR CONTRACTOR John Stone PHONE: Business Home 660-7546

ADDRESS 149-3 JC cr mooresville, N.C.

LOCATION 70E TR Triplett Rd TR Branch Rd TR Hagan 2nd lot Rt.

SUBDIVISION Amity Hill Est. BLOCK / SECTION LOT 12 LOT AREA 1.64 acres SITE CLASS PS DESIGN FLOW 360 L.T.A.R. .33

Septic Tank: 1000 Gallons: STB 1012 Date

Pump Tank: Gallons: PT Date

Pump Make: Model Serial No

Nitrification Field: No Fields 1 Square Feet 810 Linear Feet 270

No Lines 4 Trench Width 36" Max Trench Bottom Depth 36" Gravel Depth N/A

☒ New System ☐ Repair System Type: I, II, III, IV, V, VI

System Description: Gravity 25% Reduct.

Repair System Description: " " "

Maintenance Agreement Required: ☐ Yes ☐ No

☐ House/Mod. Home ☐ Mobile Home ☐ Business ☐ Other


No. Bedrooms 3 No. Bathrooms 2 No. Employees

☐ Slab ☐ Crawl Space ☐ Basement w/plumbing ☐ Basement wo/plumbing

Water Supply: ☐ Individual ☐ Public ☒ Community

Comments/Conditions:

INITIAL SITE SKETCH

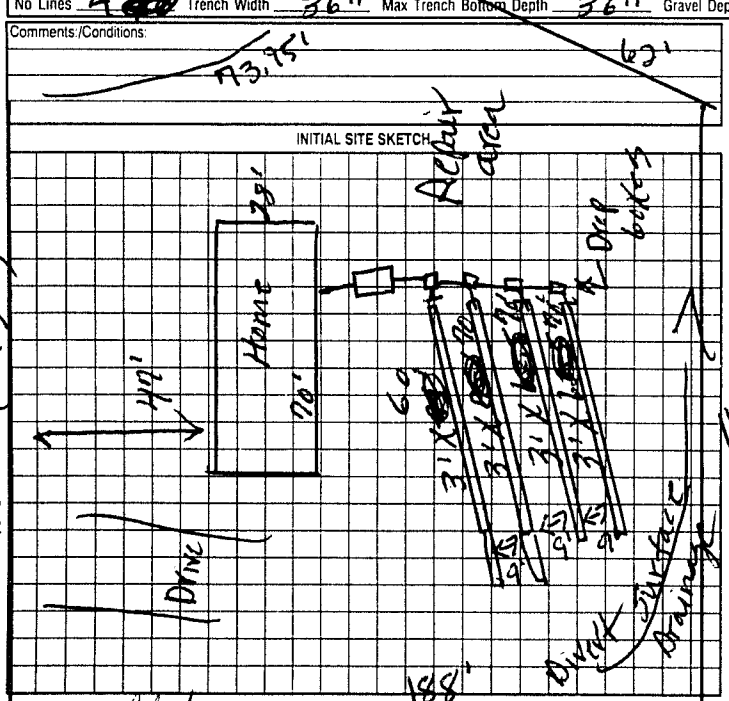

Comments/Conditions:

Polystyrene Hough Drainage EEEZZZ bay system used

AS BUILT SKETCH

Health Dept. can not make decision as to what Innovative 25% Reduction System Installer can use.

System Installed Same as initial Sketch with length changes as shown

Permit can be suspended or revoked if any false information is supplied toward securing the permit/any unauthorized changes are made to the site/any unauthorized changes are made in the installation of the system. Improvement Permit with plat valid without expiration. Improvement Permit with site plan valid for sixty months. Authorization to Construct is valid for a period equal to that of Improvement Permit – not to exceed sixty months.

Signed: date 10-1-99 Installed by: A-1 Backhoe

Improvement Permit by: E. C. Moore date 9-30-99 Operation Permit by: E. C. Moore date 10-21-99

Authorization to Construct by: E. C. Moore date 9-30-99 Existing System Inspection by: date

HEALTH DEPT COPY: WHITE OWNER COPY (FINAL): YELLOW OWNER COPY (INITIAL): PINK