Cooks Construction PW

IREDELL COUNTY HEALTH DEPARTMENT

Statesville Office (704) 878-5305 MH Mooresville Office (704) 660-3625 PERMIT # 210687

IMPROVEMENT PERMIT / AUTHORIZATION TO CONSTRUCT / OPERATION PERMIT / EXISTING SYSTEM

PIN # 4772.30 1116

APPLICANT: Timothy Dale Allman APPLICANT ADDRESS: 802 Triplett Rd Cleveland NC

SITE ADDRESS: 802 Triplett Rd Cleveland NC PHONE: 704-528-7526 ALT. PHONE: 704-791-5710

SITE DIRECTIONS: 70 E T/R Triplett Rd Property on right

SUBDIVISION: N/A SECTION: N/A LOT # N/A LOT AREA: 4.530 ac DESIGN FLOW: 100 L.T.A.R.: Ex

Septic Tank	Ex	(gal)	STB		Date				
Pump Tank		(gal)	PT		Date				
Pump Make			Model		Serial #				
# Nitrification Fields	Ex		# Lines	Ex	Linear Ft:	Ex			
Trench Width	Ex		Max. Trench Bottom Depth	Ex	Gravel Depth	Ex			

☐ New System ☐ Repair ☐ Expansion System Type: I ☒ II III IV V VI

System Description: Existing

Repair System Description:

Maintenance Agreement Required: ☐ YES ☒ NO ☒ GRAVITY ☐ PRESSURE

☐ Residence ~~No. Bedrooms~~ 3 bdrm home 1

☐ Business No. Persons

☒ Other No. Employees


☒ Slab ☐ Crawl Space

☐ Basement w/plumbing ☐ Basement w/o plumbing


Water Supply: ☒ Private ☐ Public ☐ Community

Comments / Conditions: All building foundations must be 35' from any part of STS and >25' from any well.

INITIAL SITE SKETCH

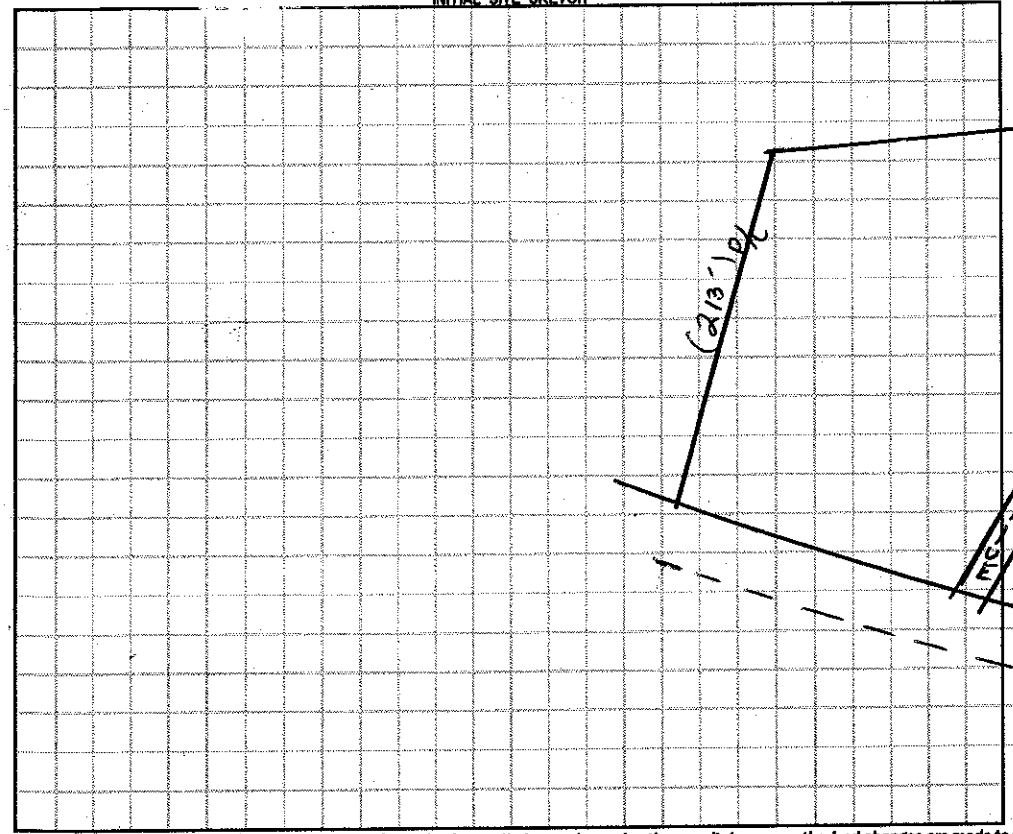

AS BUILT SKETCH

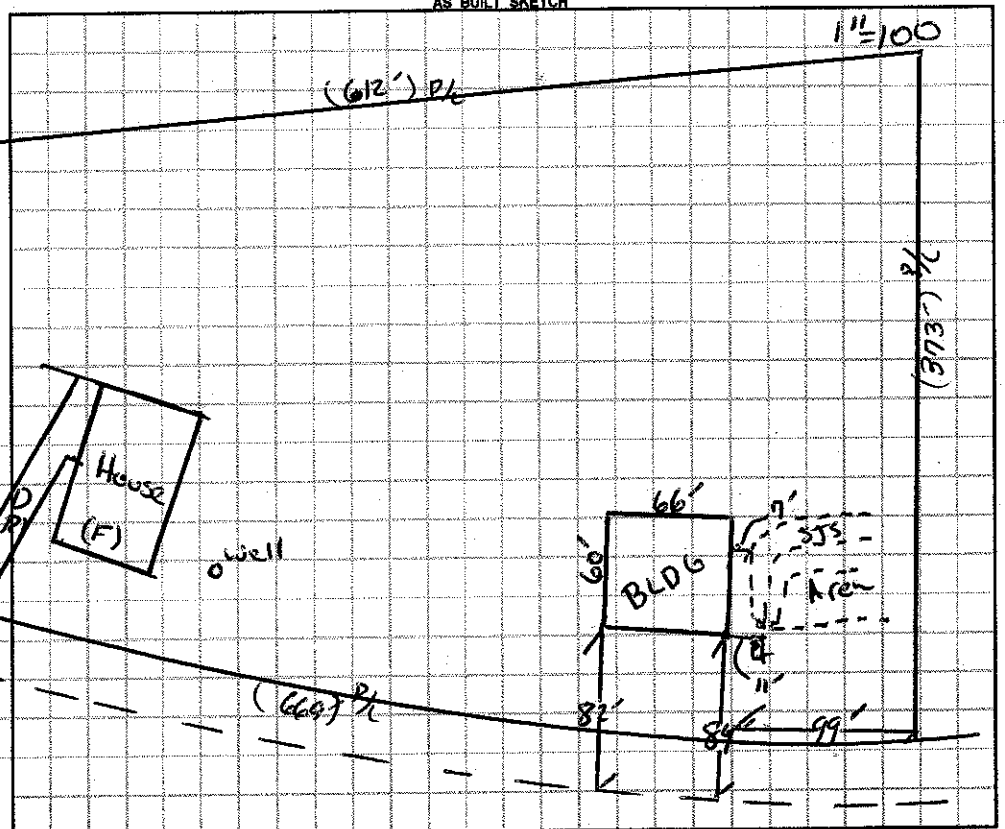

Permit can be suspended or revoked if any false information is supplied toward securing the permit / any unauthorized changes are made to the site / any unauthorized changes are made in the installation of the system. **CONTACT A LOCATOR SERVICE PRIOR TO ANY EXCAVATION**

☐ **IMPROVEMENT PERMIT** *with plat valid without expiration.* ☐ **IMPROVEMENT PERMIT** *with site plan valid for 60 mos.* ☐ **AUTHORIZATION TO CONSTRUCT** *valid for period equal to IMPROVEMENT PERMIT--not to exceed 60 mo.*

Owner / Applicant Signature: Tim Cook Date: 6-9-15 Installed by:

IMPROVEMENT PERMIT by: Date: OPERATION PERMIT by: Date:

AUTHORIZATION TO CONSTRUCT by: Date: Existing System Inspected by: Date: 06/05/15

Health Dept. Copy - WHITE Applicant (Final Approval) - YELLOW Applicant (Conditional Approval) - PINK