48762

IREDELL COUNTY HEALTH DEPARTMENT

STATESVILLE 704-878-5305 MOORESVILLE 704-664-5281

IMPROVEMENT PERMIT / CERTIFICATE OF COMPLETION / OPERATION PERMIT / EXISTING SYSTEM INSPECTION

PROPERTY DESCRIPTION NO. 17057 DATE 9-17-93 TAX MAP NO. 5F-A-88

OWNER OR CONTRACTOR Lanita Justus PHONE: Business Home 528-9267

ADDRESS PO Box 1583 Mooresville

LOCATION 70E TR Triplett Rd Past Rowan Rd 2nd mh on Rt

SUBDIVISION ✓ BLOCK / SECTION LOT LOT AREA SITE CLASS L.T.A.R

Water Supply: ☑ Individual ☐ Community ☐ Public

Septic Tank: Gallons; STB Date

Pump Tank: Gallons; PT Date

Nitrification Field: No Fields Square Feet Linear Feet

No Lines Trench Width Trench Depth Gravel Depth

☐ New System ☐ Repair System Type: I, II, III, IV, V, VI

System Description:

Repair System Description:

Maintenance Agreement Required: ☐ Yes ☐ No

☐ House/Mod Home ☑ Mobile Home ☐ Business ☐ Other

No. Bedrooms 2 No. Bathrooms 1 No. Employees

Garbage Disposal: ☐ Yes ☑ No

Auto. Dishwasher: ☐ Yes ☑ No

Auto. Washing Machine: ☐ Yes ☐ No


Other

☐ Slab ☐ Crawl Space ☐ Basement w/plumbing ☐ Basement wo/plumbing

Comments 100 over 100 to well

INITIAL SITE SKETCH

AS BUILT SKETCH

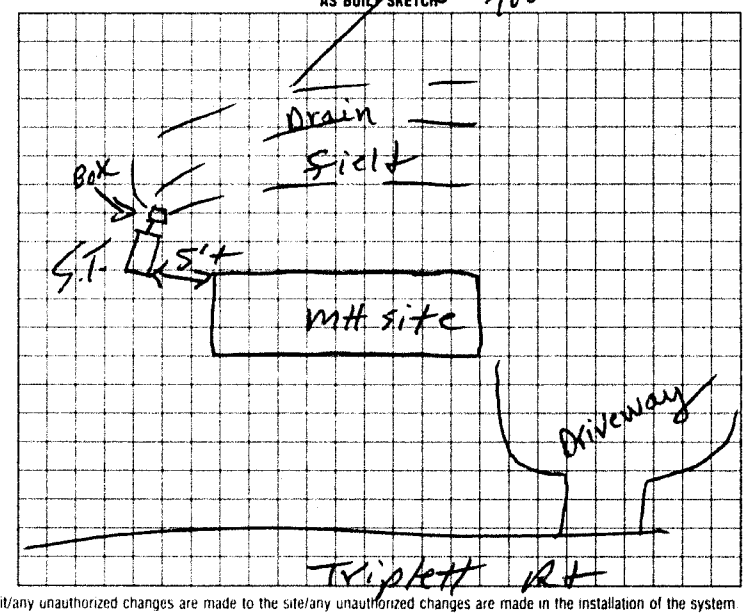

I understand that this permit can be suspended or revoked if any false information is supplied toward securing the permit/any unauthorized changes are made to the site/any unauthorized changes are made in the installation of the system. Improvement Permit is valid for 60 months from date of issuance

Signed:

Improvement Permit by: date

Existing System Inspection by: R. C. Moore date 9-17-93

Installed by

Certificate of Completion by date

Operation Permit by: date

HEALTH DEPT. COPY: WHITE INSPECTION COPY (FINAL): GREEN OWNER COPY (FINAL): YELLOW INSPECTION COPY (INITIAL): PINK OWNER COPY (INITIAL): GOLD