IREDELL COUNTY HEALTH DEPARTMENT

STATESVILLE 704-878-5305 MOORESVILLE 704-664-5281

IMPROVEMENT PERMIT / CERTIFICATE OF COMPLETION / OPERATION PERMIT / EXISTING SYSTEM INSPECTION

PROPERTY DESCRIPTION NO. 16735 DATE 7-30-93 TAX MAP NO. 5E-A-88

OWNER OR CONTRACTOR Timothy D. Honeycutt PHONE Business ~~[illegible]~~ Home

ADDRESS Rt 2 Box 280-1 ~~[illegible]~~ Troutman, N.C.

LOCATION 70 E TR Triplett Rd Part Rowan Rt 32 mH on Rt

SUBDIVISION ✓ BLOCK / SECTION LOT LOT AREA SITE CLASS L.T.A.R.

Water Supply: ✓ Individual ☐ Community ☐ Public

Septic Tank: Gallons; STB Exist Date

Pump Tank: Gallons; PT Date

Nitrification Field: No Fields Square Feet Linear Feet

No Lines Trench Width Trench Depth Gravel Depth

☐ New System ☐ Repair System Type: I, II, III, IV, V, VI

System Description:

Repair System Description:

Maintenance Agreement Required: ☐ Yes ☐ No

~~House~~/Mod Home ~~Mobile Home~~ Business Other

No. Bedrooms 3 No. Bathrooms 1 No. Employees

Slab Crawl Space Basement w/plumbing Basement wo/plumbing

Garbage Disposal: ☐ Yes ~~☐ No~~ ✓

Auto. Dishwasher: ☐ Yes ~~☐ No~~ ✓


Auto. Washing Machine: ~~☐ Yes~~ ✓ ☐ No

Other

Comments

INITIAL SITE SKETCH

AS BUILT SKETCH

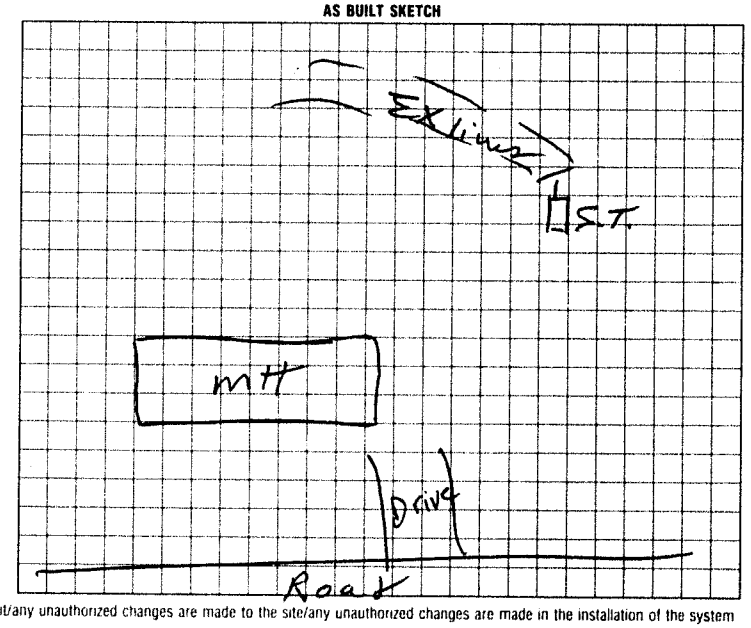

I understand that this permit can be suspended or revoked if any false information is supplied toward securing the permit/any unauthorized changes are made to the site/any unauthorized changes are made in the installation of the system Improvement Permit is valid for 60 months from date of issuance.

Signed:

Improvement Permit by: date

Existing System Inspection by: L.C. Moore date 7-30-93

Installed by

Certificate of Completion by date

Operation Permit by date

HEALTH DEPT. COPY. WHITE INSPECTION COPY (FINAL) GREEN OWNER COPY (FINAL) YELLOW INSPECTION COPY (INITIAL) PINK OWNER COPY (INITIAL) GOLD