IREDELL COUNTY HEALTH DEPARTMENT

STATESVILLE 704-878-5305 MOORESVILLE 704-664-5281

IMPROVEMENT PERMIT / AUTHORIZATION TO CONSTRUCT / OPERATION PERMIT / EXISTING SYSTEM INSPECTION

PERMIT# 089497 PIN# 4772 30 7178 (pt) DATE June 5, 2000

OWNER OR CONTRACTOR Milton BEAVER PHONE: Business 528-5856 Home

ADDRESS 107 Hemlock Rd. Cleveland 27013

LOCATION 70 EAST TR Triplett Rd. TL Rowan Rd. immediately on Right

SUBDIVISION BLOCK / SECTION LOT LOT AREA 150'X320' SITE CLASS IS DESIGN FLOW 440gpd L.T.A.R. .3

Septic Tank: 1500 Gallons; STB 1014 Date 1/15/99
Pump Tank: Gallons; PT Date
Pump Make: Model Serial No.
Nitrification Field: No Fields 1 Square Feet 1200 Linear Feet 400
No Lines 4 @ 100' Trench Width 36" Max Trench Bottom Depth 36"±

☑ New System ☐ Repair System Type: I. II. III. IV. V. VI
System Description: Gravity Innovative-25% Red.
Repair System Description: Grd/pumped Innovative
Maintenance Agreement Required? ☐ Yes ☑ No
Gravel Depth N/A ☑ Slab ☐ Crawl Space ☐ Basement w/plumbing ☐ Basement wo/plumbing


☐ House/Mod. Home No. Bedrooms 4
☐ Mobile Home No. Bathrooms 4
☐ Business No. Employees
☑ Other Duplex Apt.

Water Supply: ☑ Individual ☐ Public ☐ Community


Comments/Conditions: ① ONE inspection port per Lateral, set flush with finished grade.

Comments/Conditions:

INITIAL SITE SKETCH

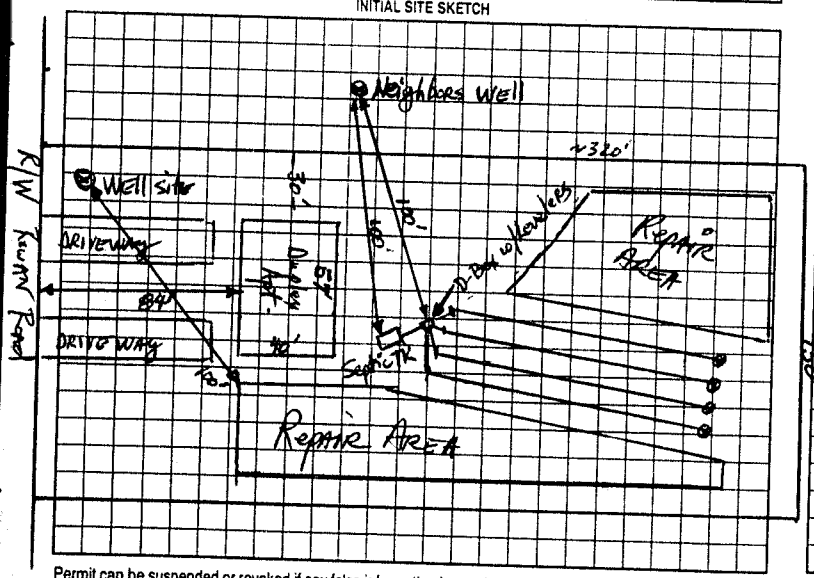

AS BUILT SKETCH

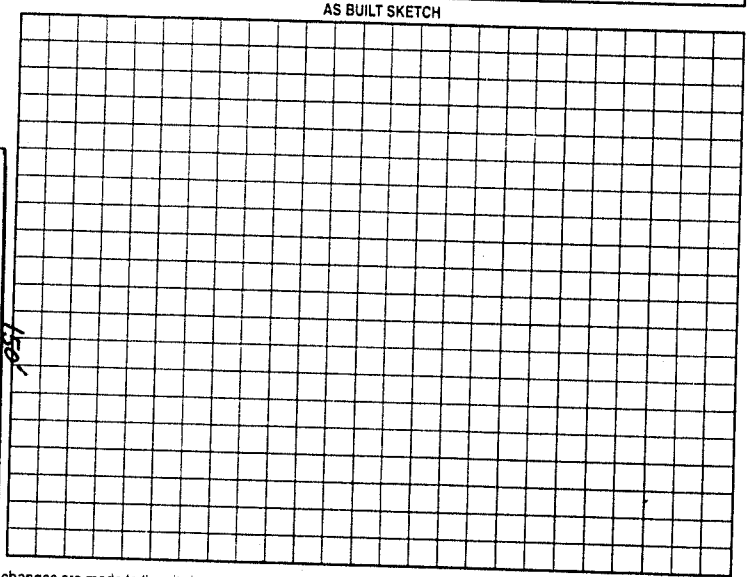

Permit can be suspended or revoked if any false information is supplied toward securing the permit/any unauthorized changes are made to the site/any unauthorized changes are made in the installation of the system. Improvement Permit with plat valid without expiration. Improvement Permit with site plan valid for sixty months. Authorization to Construct is valid for a period equal to that of Improvement Permit – not to exceed sixty months.

Signed: Milton Beaver date 6-8-2000

Improvement Permit by: [signature] RS date 6-5-2000

Authorization to Construct by: [signature] RS date 6-5-2000

Installed by: Milton Beaver

Operation Permit by: [signature] RSI date 10/10/00

Existing System Inspection by: date

HEALTH DEPT. COPY: WHITE OWNER COPY (FINAL): YELLOW OWNER COPY (INITIAL): PINK