IREDELL COUNTY HEALTH DEPARTMENT

STATESVILLE 704-878-5305 (01) MOORESVILLE 704-664-5281

IMPROVEMENT PERMIT / AUTHORIZATION TO CONSTRUCT / OPERATION PERMIT / EXISTING SYSTEM INSPECTION

PERMIT# 134187 PIN# ~~4772-31-1029~~ 4772-30-0916 DATE 5-1-2006

OWNER OR CONTRACTOR JOHN V. & WANDA S. REDDEN PHONE: Business 704-528-1893 Home 704-664-3121

ADDRESS 768 TRIPLETT ROAD, CLEVELAND, NC 27013

LOCATION US 70 EAST, TR TRIPLETT ROAD, ON RIGHT ACROSS FROM ROWAN ROAD, 330' BACK off ROAD

SUBDIVISION JOHN REDDEN BLOCK / SECTION ____ LOT 1 LOT AREA 1.485 ACRES SITE CLASS. PS DESIGN FLOW 360 L.T.A.R. 0.25 GPD/FT2

Septic Tank: 1000 Gallons; STB 1012 Date 5-19-06
Pump Tank: ____ Gallons; PT ____ Date ____
Pump Make: ____ Model ____ Serial No. ____
Nitrification Field: No Fields 1 Square Feet EQ. TO 1440 Linear Feet 360
No Lines SIX Trench Width 36" Max Trench Bottom Depth 36" Gravel Depth N/A

☑ New System ☐ Repair System Type: I, II, III, IV, V, VI
System Description: 25% REDUCTION, GRAVITY
Repair System Description: 50% REDUCTION LOW PRESSURE
Maintenance Agreement Required: ☐ Yes ☑ No


☑ House/Mod. Home No. Bedrooms 3
☐ Mobile Home No. Bathrooms ____
☐ Business No. Employees ____
☐ Other ____
☐ Slab ☑ Crawl Space ☐ Basement w/plumbing ☐ Basement wo/plumbing

Water Supply: ☑ Individual ☐ Public ☐ Community
WELL


Comments:/Conditions: (1) INSTALL 25% REDUCTION SYSTEM ON CONTOUR AS SHOWN & FLAGGED ON SITE. (2) NO GRADING OR FILLING ALLOWED OVER AREA OF DRAINFIELD OR REPAIR AREA.

Comments:/Conditions: SEPTIC TANK WITH MARKER INSTALLED USING "TUFFITE" FILTER

INITIAL SITE SKETCH

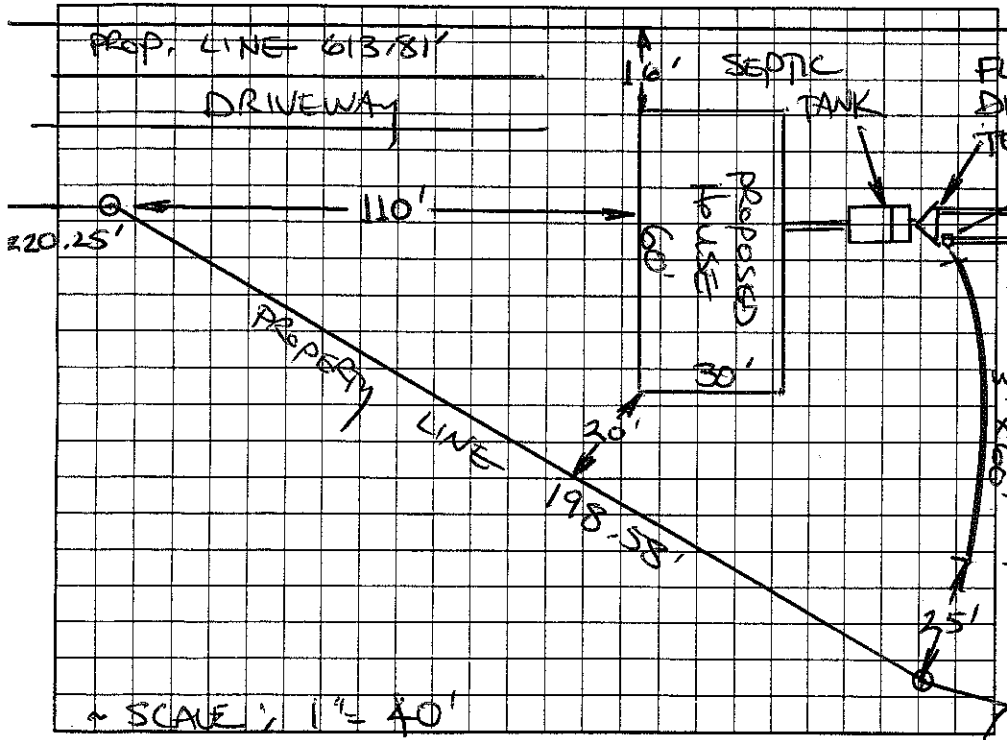

AS BUILT SKETCH

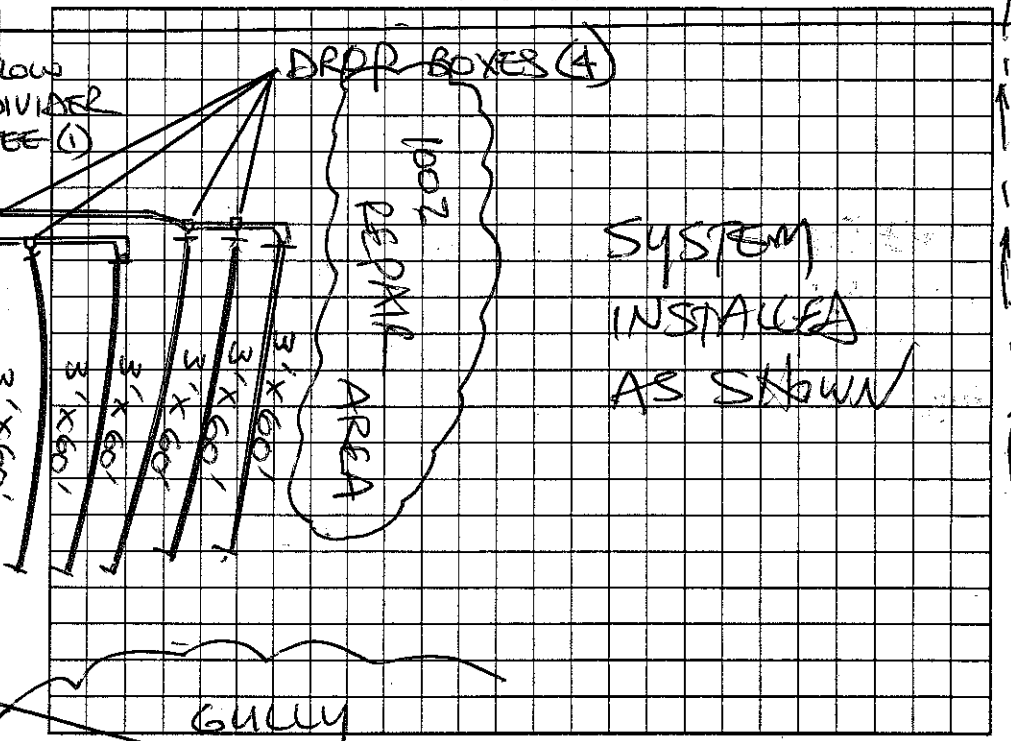

Permit can be suspended or revoked if any false information is supplied toward securing the permit/any unauthorized changes are made to the site/any unauthorized changes are made in the installation of the system. Improvement Permit with plat valid without expiration. Improvement Permit with site plan valid for sixty months. Authorization to Construct is valid for a period equal to that of Improvement Permit – not to exceed sixty months.

Signed: John Redden date ____ Installed by: STEVE JORDAN

Improvement Permit by: STEVE HEDRICK date 5-1-2006 Operation Permit by: STEVE HEDRICK date 8-1-06

Authorization to Construct by: STEVE HEDRICK date 5-1-2006 Existing System Inspection by: ____ date ____

HEALTH DEPT. COPY: WHITE OWNER COPY (FINAL): YELLOW OWNER COPY (INITIAL): PINK