IREDELL COUNTY HEALTH DEPARTMENT

STATESVILLE 704-878-5305 MOORESVILLE 704-664-5281

IMPROVEMENT PERMIT / AUTHORIZATION TO CONSTRUCT / OPERATION PERMIT / EXISTING SYSTEM INSPECTION

PERMIT# 134189 PIN# ~~4772-31-1029~~ 4772-31-1144 DATE 5-1-06

OWNER OR APPLICANT JOHN V. & WANDA S. REDDEN PHONE: Business 704-528-1893 Home 704-664-3121

ADDRESS 766 TRIPLETT ROAD CLEVELAND, NC 27013

LOCATION US 70 EAST, TR TRIPLETT ROAD, ON RIGHT ACROSS FROM ROWAN ROAD, 340' BACK off ROAD.

SUBDIVISION JOHN REDDEN BLOCK / SECTION ____ LOT 2 LOT AREA 2.353 ACRES SITE CLASS. PS DESIGN FLOW 360 L.T.A.R. 0.25 GPD/FT²

Septic Tank: 1000 Gallons; STB 1012 Date 3-18-06
Pump Tank: ____ Gallons; PT ____ Date ____
Pump Make: ____ Model ____ Serial No. ____
Nitrification Field: No Fields 1 Square Feet ~~691.10~~ 1440 Linear Feet 360
No Lines FOUR Trench Width 36" Max Trench Bottom Depth 36" Gravel Depth N/A

☑ New System ☐ Repair ☐ Expansion System Type: I II III IV V VI
System Description: 25% REDUCTION, GRAVITY
Repair System Description: 50% REDUCTION, LOW PRESSURE
Maintenance Agreement Required: ☐ Yes ☑ No ☐ Other ____
☑ Gravity ☐ Pressure


☑ House/Mod. Home ☐ Mobile Home ☐ Business
No. Bedrooms 3 No. Persons ____ No. Employees ____

Water Supply: ☑ Individual ☐ Public ☐ Community

☐ Slab ☑ Crawl Space ☐ Basement w/plumbing ☐ Basement wo/plumbing


Comments/Conditions: ① INSTALL 25% REDUCTION SYSTEM ON CONTOUR AS SHOWN ② NO GRADING OR FILLING ALLOWED OVER AREA OF DRAINFIELD OR REPAIR AREA ③ NO VEHICULAR TRAFFIC ALLOWED OVER EXISTING SYSTEM

INITIAL SITE SKETCH

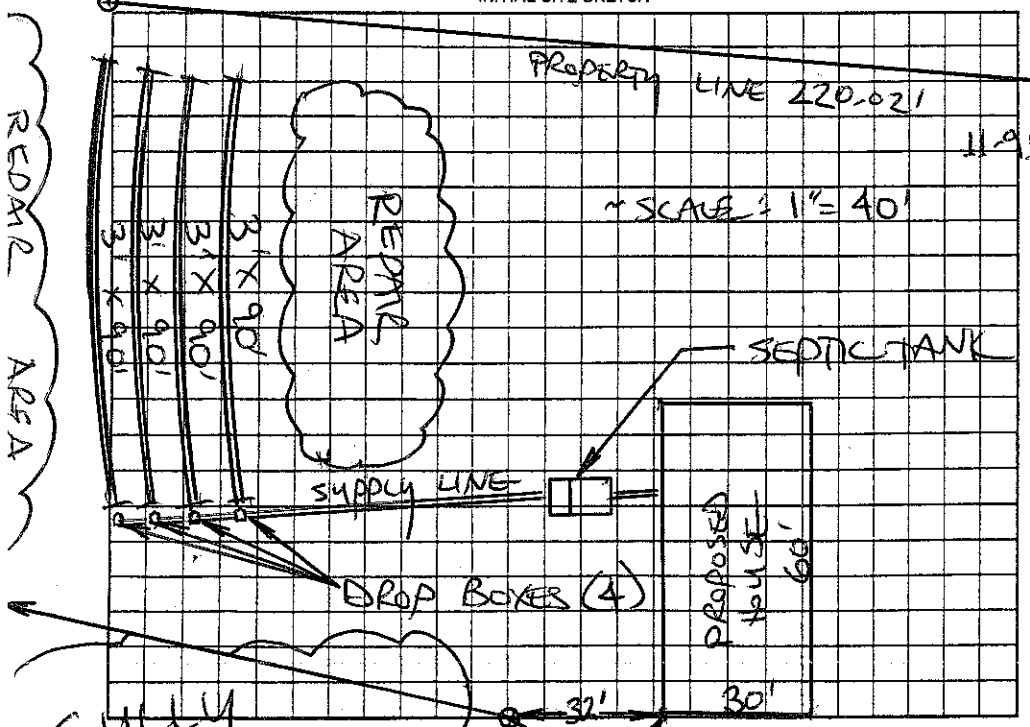

Comments/Conditions: ④ KEEP SYSTEM MINIMUM 100' FROM WELL.
SEPTIC TANK W/ MARKER & "TUFFTITE" FILTER

AS BUILT SKETCH

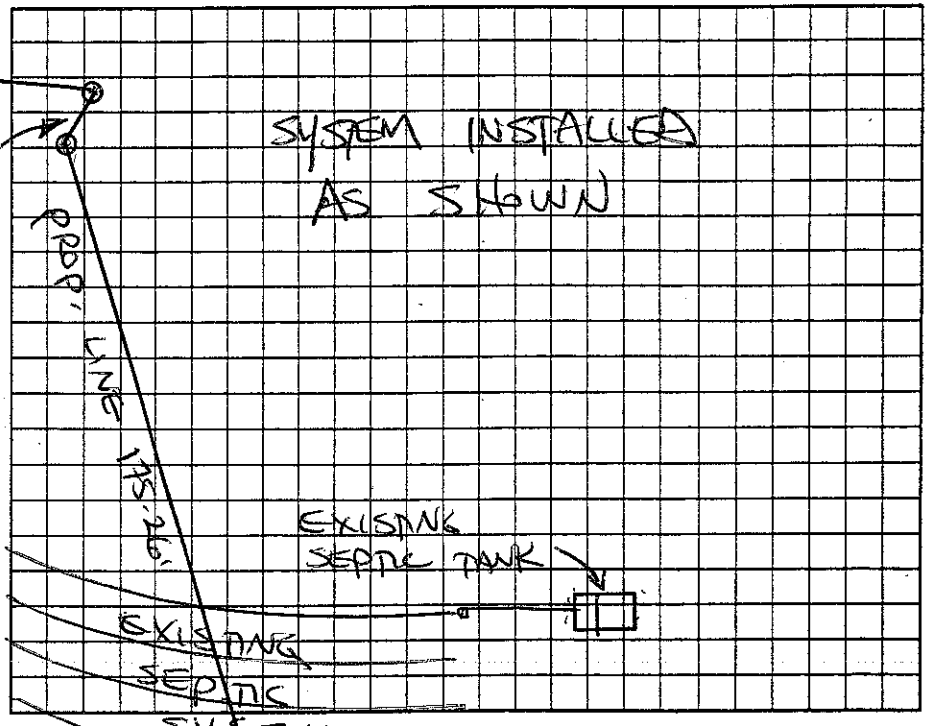

Permit can be suspended or revoked if any false information is supplied toward securing the permit/any unauthorized changes are made to the site/any unauthorized changes are made in the installation of the system. Improvement Permit with plat valid without expiration ☐ Improvement Permit with site plan valid for sixty months ☒ Authorization to Construct is valid for a period equal to that of Improvement Permit – not to exceed sixty months.

Signed: ____ date ____ Installed by: PIEDMONT BACKHOE SERVICE

Improvement Permit by: STEVE HEDRICK date 5-1-06 Operation Permit by: STEVE HEDRICK date 8-2-06

Authorization to Construct by: ~~STEVE HEDRICK~~ STEVE HEDRICK date ~~5-1-06~~ 5-1-06 Existing System Inspection by: ____ date ____

HEALTH DEPT. COPY: WHITE OWNER COPY (FINAL): YELLOW OWNER COPY (INITIAL): PINK