IREDELL COUNTY HEALTH DEPARTMENT

Statesville Office (704) 878-5305 Mooresville Office (704) 660-3625 PERMIT # 220305

IMPROVEMENT PERMIT / AUTHORIZATION TO CONSTRUCT / OPERATION PERMIT / EXISTING SYSTEM

PIN # 4772 31 1299

APPLICANT: KEITH LATTIN APPLICANT ADDRESS: 742 TRIPLETT RD CLEVELAND, NC 27013

SITE ADDRESS: 742 TRIPLETT RD, Mocksville PHONE: 607-250-7001 ALT. PHONE:

SITE DIRECTIONS: 70E R BETHESDA TL CORNFLOWER TR TRIPLETT #742 TR LASTON L ON GRAVEL DRIVE

SUBDIVISION: ROBERT F STILTNER SECTION: — LOT # 2 LOT AREA: 1.153 DESIGN FLOW: 360 L.T.A.R.: NA

Septic Tank 1000 (gal) STB 760 Date 6-20-16
Pump Tank (gal) PT Date
Pump Make Model Serial #
Nitrification Fields # Lines Linear Ft:
Trench Width Max. Trench Bottom Depth Gravel Depth


☐ New System ☑ Repair ☐ Expansion System Type: I (II) III IV V VI
System Description: REPLACE OLD ST WITH NEW
Repair System Description:
Maintenance Agreement Required: ☐ YES ☑ NO
☑ GRAVITY ☐ PRESSURE

☑ Residence ☐ Business ☐ Other ☐ Slab ☐ Basement w/plumbing ☑ Basement w/o plumbing
No. Bedrooms 3 No. Persons No. Employees ☐ Crawl Space

Water Supply: ☑ Private ☐ Public ☐ Community


Comments / Conditions: REPLACE OLD ST WITH 1000 GAL ST.
BASEMENT - NEED TO BE > 15' FROM WALL WITH NEW TANK.

INITIAL SITE SKETCH

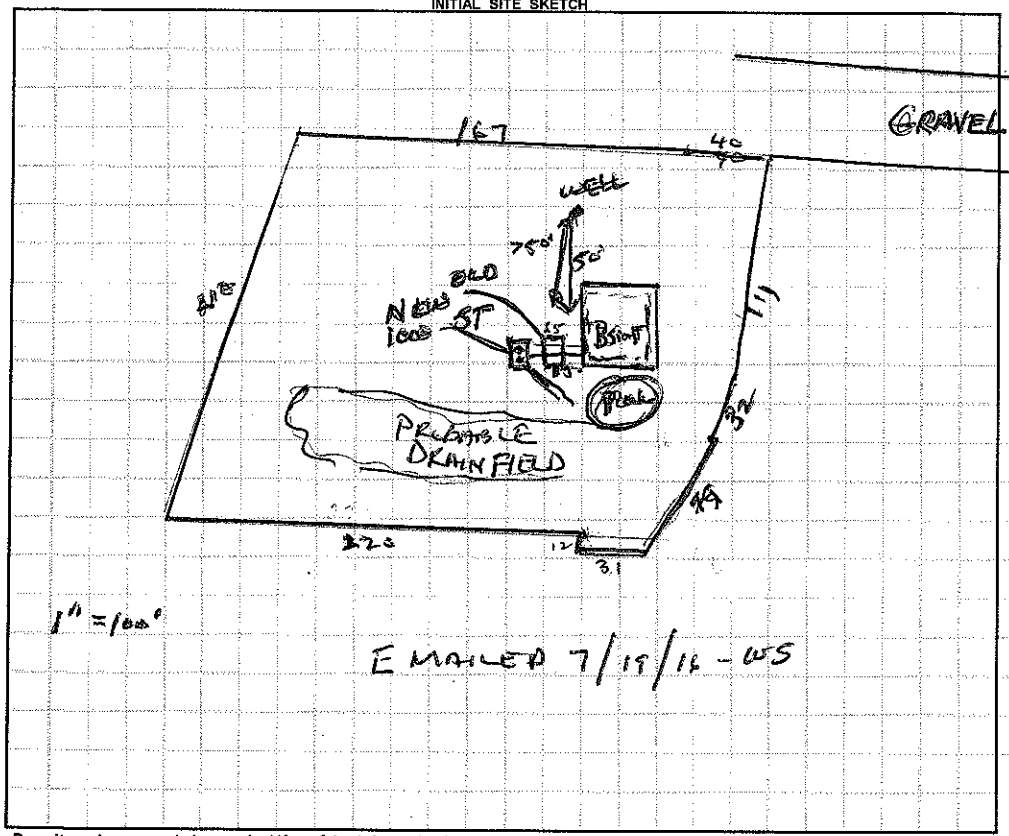

EMAILED 7/19/16 - WS

AS BUILT SKETCH

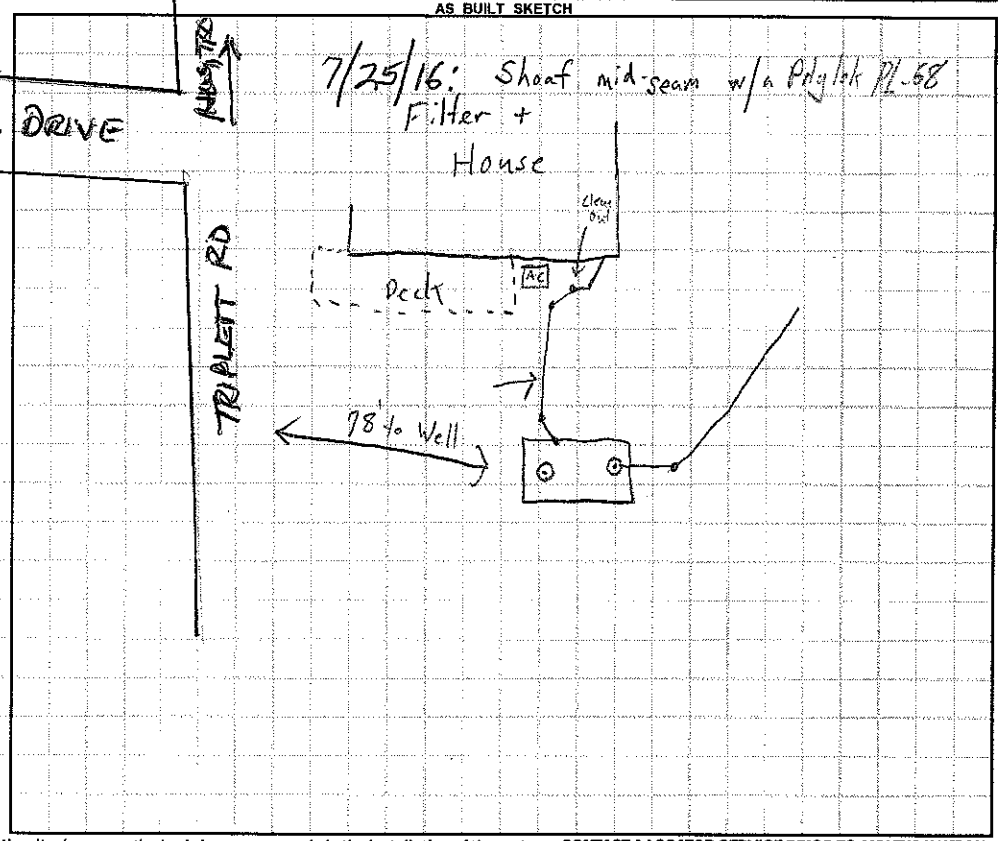

Permit can be suspended or revoked if any false information is supplied toward securing the permit / any unauthorized changes are made to the site / any unauthorized changes are made in the installation of the system. **CONTACT A LOCATOR SERVICE PRIOR TO ANY EXCAVATION**

☐ **IMPROVEMENT PERMIT** *with plat valid without expiration.* ☐ **IMPROVEMENT PERMIT** *with site plan valid for 60 mos.* ☑ **AUTHORIZATION TO CONSTRUCT** *valid for period equal to IMPROVEMENT PERMIT--not to exceed 60 mo.*

Owner / Applicant Signature: Keith Lattin Date: 7-19-16 Installed by: Jarrid Lentz w/ Lentz Septic

IMPROVEMENT PERMIT by: Wesley Sparks Date: 7/19/16 OPERATION PERMIT by: Tom Shook Date: 7-25-16

AUTHORIZATION TO CONSTRUCT by: Wesley Sparks Date: 7/19/16 Existing System Inspected by: Date:

Health Dept. Copy - WHITE Applicant (Final Approval) - YELLOW Applicant (Conditional Approval) - PINK