IREDELL COUNTY HEALTH DEPARTMENT

Statesville Office (704) 878-5305 Mooresville Office (704) 660-3625 PERMIT # 203138

IMPROVEMENT PERMIT / AUTHORIZATION TO CONSTRUCT / OPERATION PERMIT / EXISTING SYSTEM

PIN # 4772323100

APPLICANT: Freedom Homes APPLICANT ADDRESS: 1042 Charlotte Hwy

SITE ADDRESS: 714 Triplett Rd. PHONE: 704-883-6145 ALT. PHONE: N/A

SITE DIRECTIONS: Hwy 70E TR Triplett Rd Property on Right


SUBDIVISION: Charlie Upright SECTION: N/A LOT # 2B LOT AREA: 1.07acres DESIGN FLOW: 360gpd L.T.A.R.: 0.03

Septic Tank	1000 (gal)	STB	1012-1000	Date	3-15-14	☑ New System	☐ Repair	☐ Expansion	System Type: I II ~~III~~ IV V VI
Pump Tank	(gal)	PT		Date		System Description:	25% Reduction		
Pump Make		Model		Serial #		Repair System Description:	25% Reduction		
# Nitrification Fields	1	# Lines	5	Linear Ft:	300	Maintenance Agreement Required:	☐ YES	☑ NO	
Trench Width	36"	Max. Trench Bottom Depth	36"	Gravel Depth	N/A		☑ GRAVITY	☐ PRESSURE	


☑ Residence	No. Bedrooms	3	Water Supply	
☐ Business	No. Persons	6	☑ Private	
☐ Other	No. Employees		☐ Public	
☐ Slab	☑ Crawl Space		☐ Community	
☐ Basement w/plumbing	☐ Basement w/o plumbing			

Comments / Conditions: Install a 25% Reduction system on contour with serial distribution. Maintain a minimum of 10' between existing water line & all components of septic tank system.

INITIAL SITE SKETCH

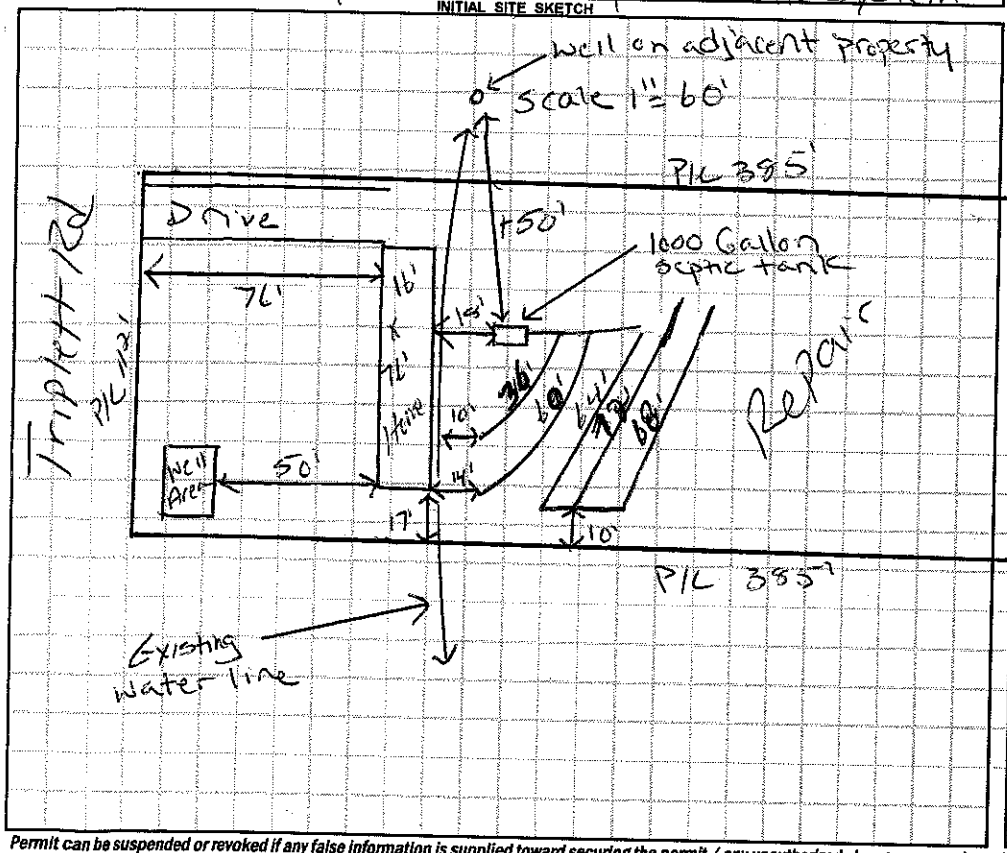

AS BUILT SKETCH

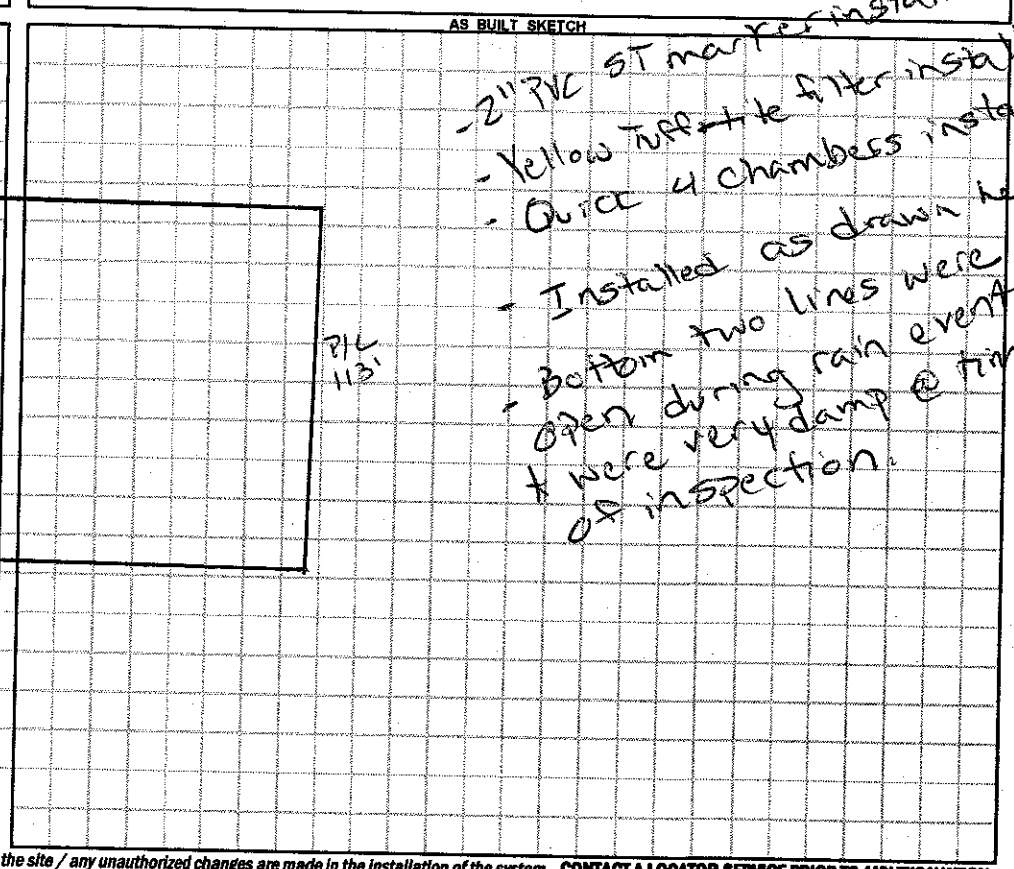

Permit can be suspended or revoked if any false information is supplied toward securing the permit / any unauthorized changes are made to the site / any unauthorized changes are made in the installation of the system. **CONTACT A LOCATOR SERVICE PRIOR TO ANY EXCAVATION**

☐ **IMPROVEMENT PERMIT** *with plat valid without expiration.* ☑ **IMPROVEMENT PERMIT** *with site plan valid for 60 mos.* ☑ **AUTHORIZATION TO CONSTRUCT** *valid for period equal to IMPROVEMENT PERMIT--not to exceed 60 mo.*

Owner / Applicant Signature: Eric Wood Date: 6-6-14 Installed by: Tommy Frye

IMPROVEMENT PERMIT by: Justin Henderson Date: 6-5-14 OPERATION PERMIT by: Justin Henderson Date: 6-10-14

AUTHORIZATION TO CONSTRUCT by: Justin Henderson Date: 6-5-14 Existing System Inspected by: Date:

Health Dept. Copy - WHITE Applicant (Final Approval) - YELLOW Applicant (Conditional Approval) - PINK